City of Prince George
HISTORY SHEET

SHEET NUMBER № 1903 **Roll Number** 01285/027

Legal: LOT'S 11 BLOCK D.L. 957 PLAN 9675

Address: 508 N. BLACKBURN ROAD

Sanitary Connection: # 10030 SIZE 4" MATERIAL P.V.C INV. 89.89 CONNECTED DEC 76

Water Connection # B 1D SIZE 19mm MATERIAL CU METER CONNECTED

Storm Connection: # SIZE MATERIAL INV. CONNECTED

Cash Receipt No's: WATER MAY 25/71 SANITARY 0250 STORM

CURB FROM PROPERTY LINE PAVEMENT WIDTH

B.C. HYDRO UNDERGROUND CONNECTION

B.C. TELEPHONE UNDERGROUND CONNECTION

INLAND GAS

Information Sheets:

Comments:
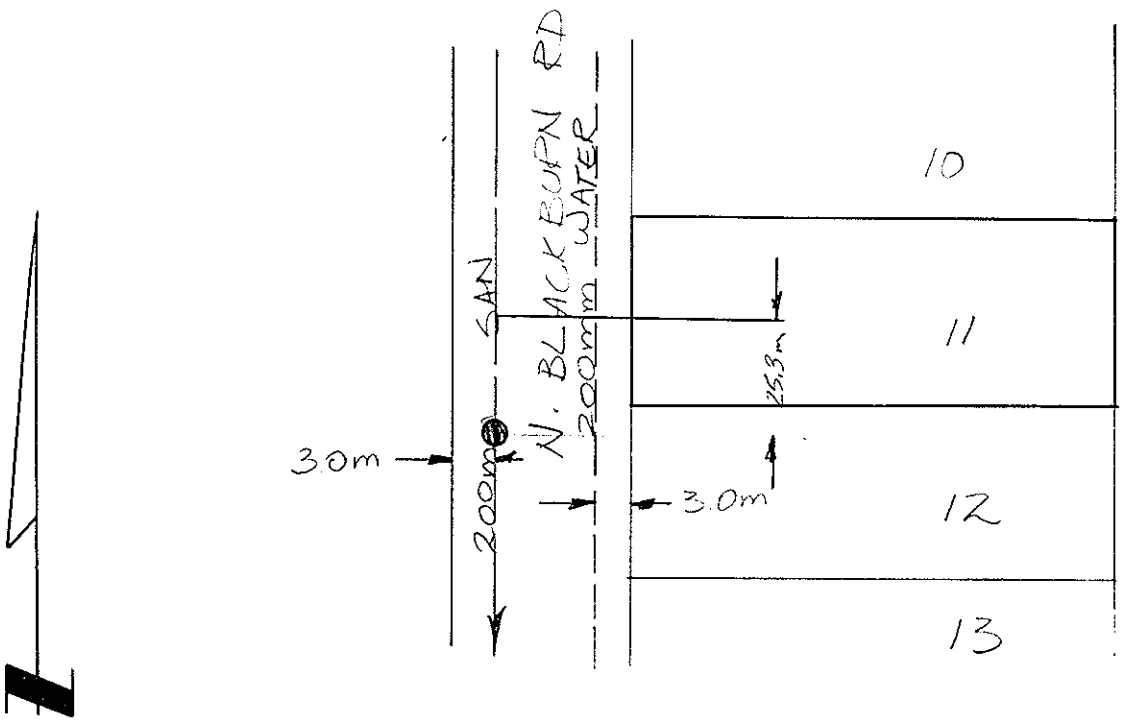
SITE PLAN N.T.S.