City of Prince George
HISTORY SHEET

SHEET NUMBER **1525** **Roll Number**

Legal: LOT'S 21 & 22 BLOCK 179 D.L. 343 PLAN 1268

Address: 1784 8th AVENUE

Sanitary Connection: # 2529 SIZE MATERIAL INV. CONNECTED

Water Connection # 2990 SIZE 3/4" MATERIAL COPPER METER CONNECTED YES

Storm Connection: # SIZE MATERIAL INV. CONNECTED

Cash Receipt No's: WATER SANITARY STORM

CURB FROM PROPERTY LINE 15' PAVEMENT WIDTH 36'

B.C. HYDRO O. H. UNDERGROUND CONNECTION

B.C. TELEPHONE O. H. UNDERGROUND CONNECTION

INLAND GAS IN LANE & 2" MAIN

Information Sheets:

Comments: BENCH MARK # 43-77 ELEVATION = 1897.23

S.I.P. S.E. CORNER 8th AND WINNIPEG
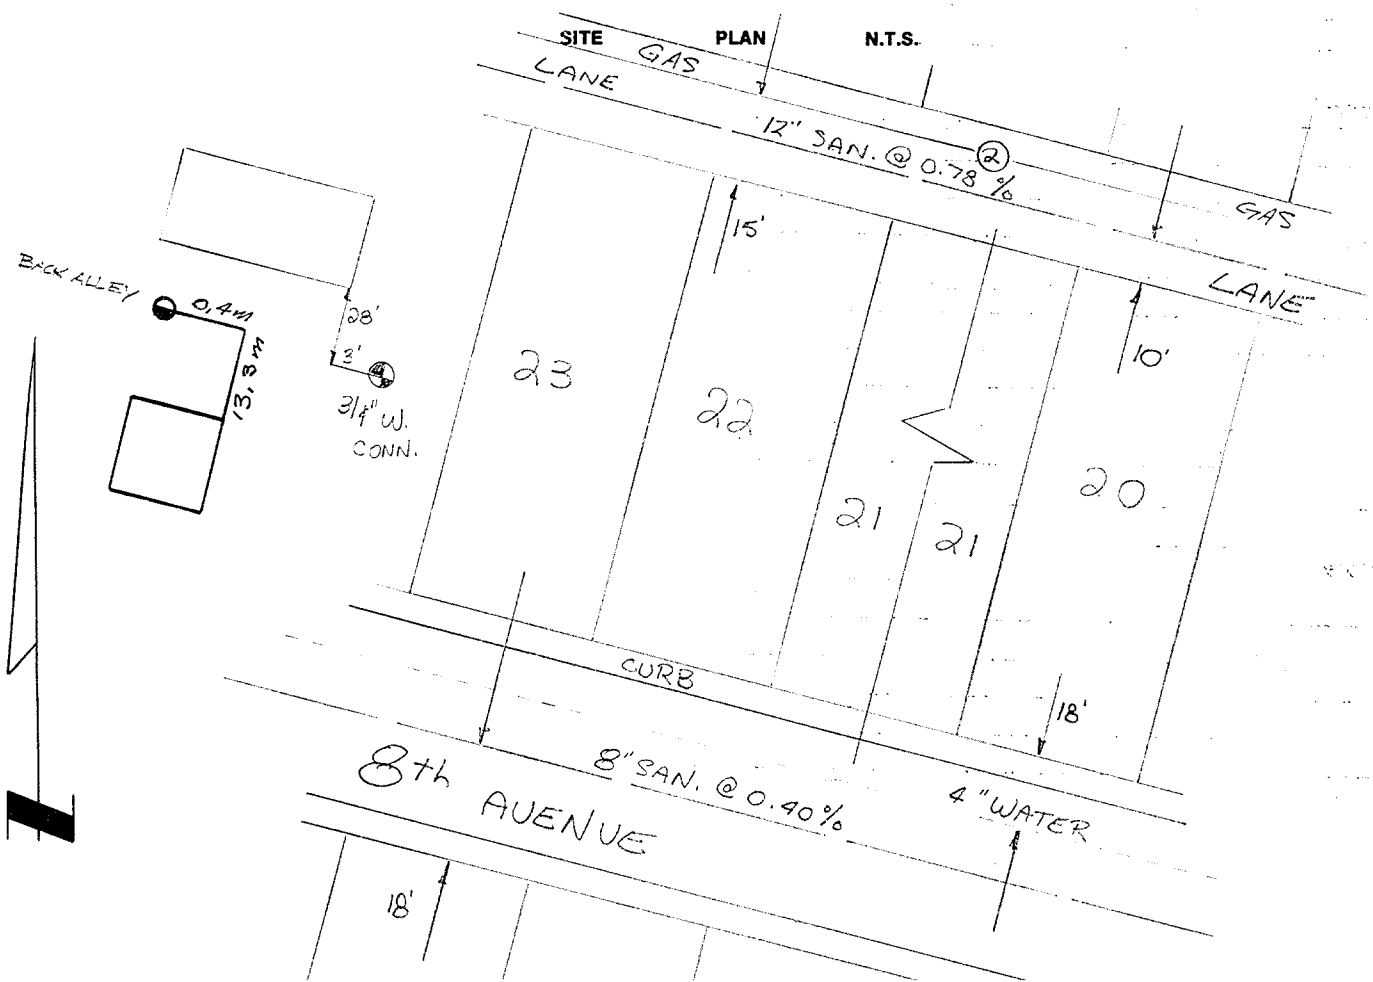
SITE PLAN N.T.S.