City of Prince George
HISTORY SHEET

Installation Date: Unknown

PID: 012888630/012888648
012888656/012888664

Legal: Lot 1-15 **Blk:** 185 **DL:** 343 **PL:** 1268

Address: 1111 7th Ave

Fibreoptics Yes **Depth:** **Connected:** Y

Sanitary Connection #: 10021 **Size:** 100mm **Material:** AC **Depth:** Inv 567.78m **Connected:** Y

Water Connection #: 300 **Size:** 50mm **Material:** CU **Depth:** **Connected:** Y

Storm Connection #: 553 **Size:** 150mm **Material:** AC **Depth:** **Connected** Y

Cash Receipt Nos: **Water** **Sanitary** 780 **Storm** 781

Curb from Property Line 10 ft **Pavement Width** 60 ft

Shaw Yes

BC Hydro **U/G Connection** Yes - see PGDocs 182328

Telus **U/G Connection** Yes - see PGDocs 182328

Terasen Yes

Information Sheets:

Comments: ST. RP. - 31.9 SAN. RP. 6 PGDocs 182328 Bench Mark #568-77, Elev = 569.464m
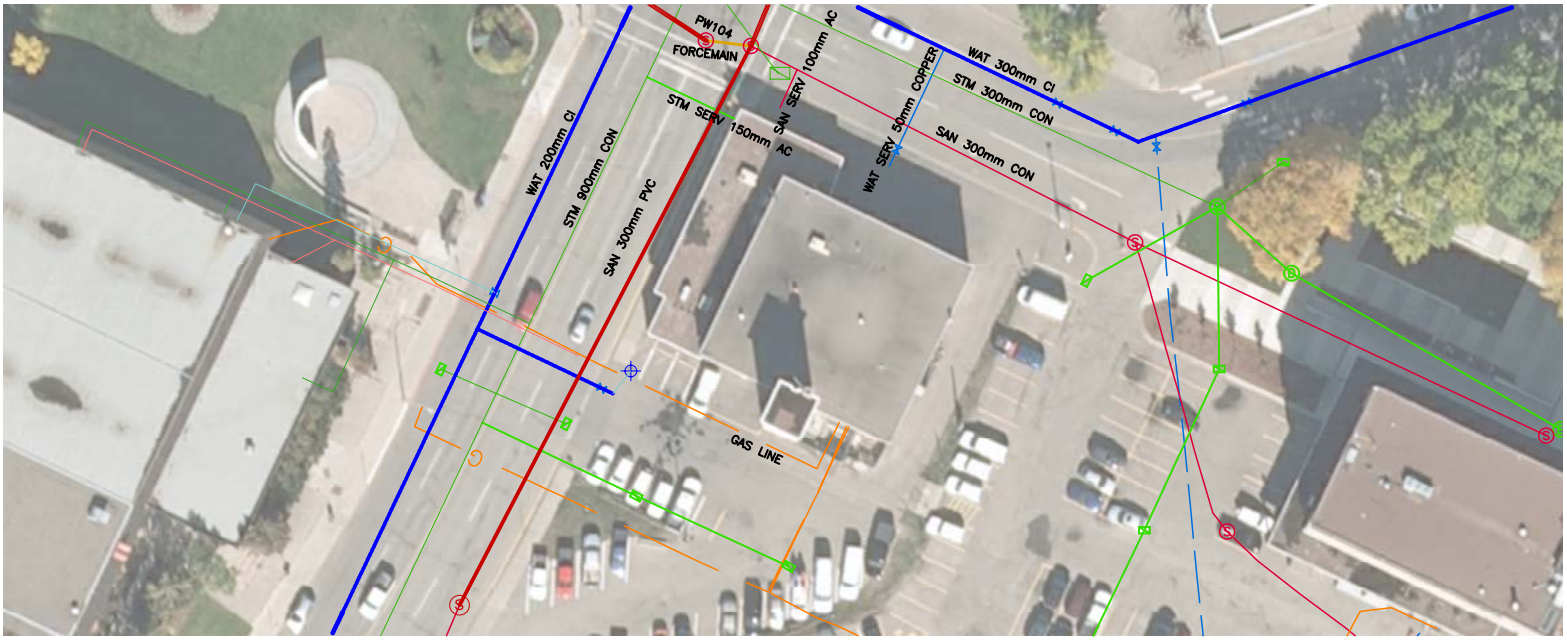
The information contained herein is for internal use only. Not to be relied upon unless confirmed by site inspection and/or investigation.