City of Prince George
HISTORY SHEET

012 906786

SHEET NUMBER 10588 **Roll Number**

Legal: LOT'S 1 BLOCK D.L. 4031 PLAN 9584

Address: OLD SUMMIT LAKE RD.

Sanitary Connection: # SIZE MATERIAL INV. CONNECTED

Water Connection # SIZE MATERIAL METER CONNECTED

Storm Connection: # SIZE MATERIAL INV. CONNECTED

Cash Receipt No's: WATER SANITARY STORM

CURB FROM PROPERTY LINE PAVEMENT WIDTH

B.C. HYDRO UNDERGROUND CONNECTION

B.C. TELEPHONE UNDERGROUND CONNECTION

INLAND GAS

Information Sheets:

Comments:
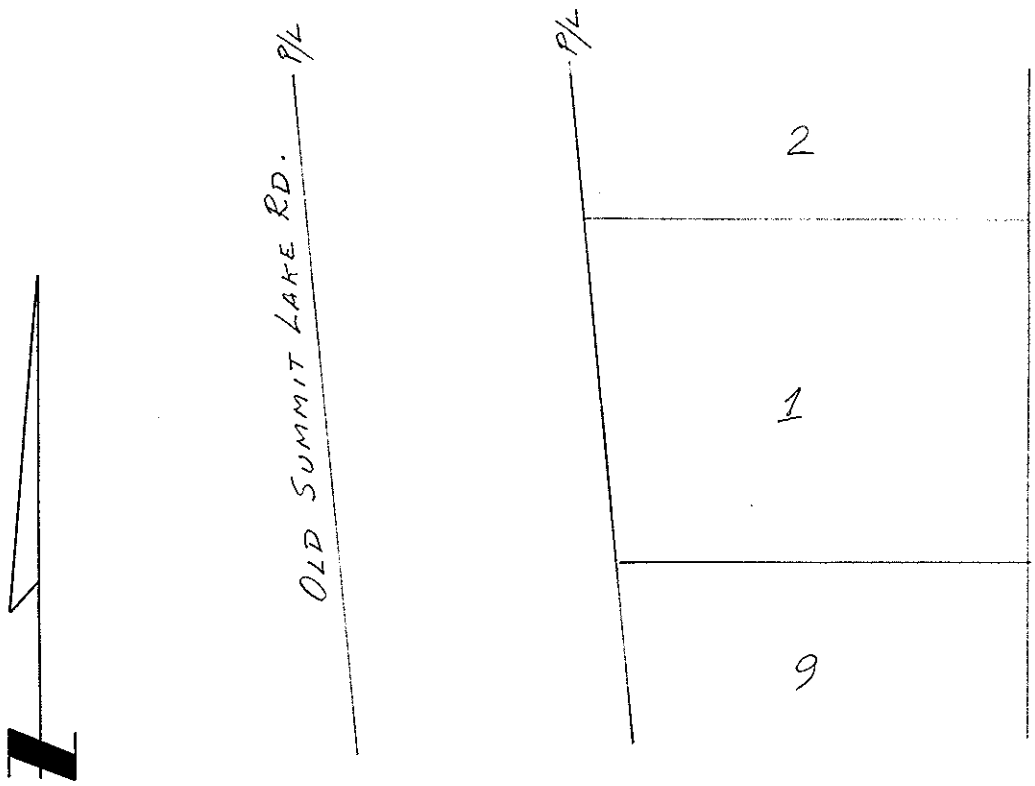
SITE PLAN N.T.S.