City of Prince George
HISTORY SHEET

SHEET NUMBER 10731 **Roll Number** 312943152

Legal: LOT'S 7 BLOCK D.L. 4377 PLAN 9186

Address: 2095 O'KEEFE AVE

Sanitary Connection: # 15148 SIZE 100mm MATERIAL INV. CONNECTED

Water Connection # 15148 SIZE 20mm MATERIAL METER CONNECTED

Storm Connection: # SIZE MATERIAL INV. CONNECTED

Cash Receipt No's: WATER 515 SANITARY 516 STORM

CURB FROM PROPERTY LINE PAVEMENT WIDTH

B.C. HYDRO O/H UNDERGROUND CONNECTION

B.C. TELEPHONE O/H UNDERGROUND CONNECTION

INLAND GAS AS SHOWN

Information Sheets:
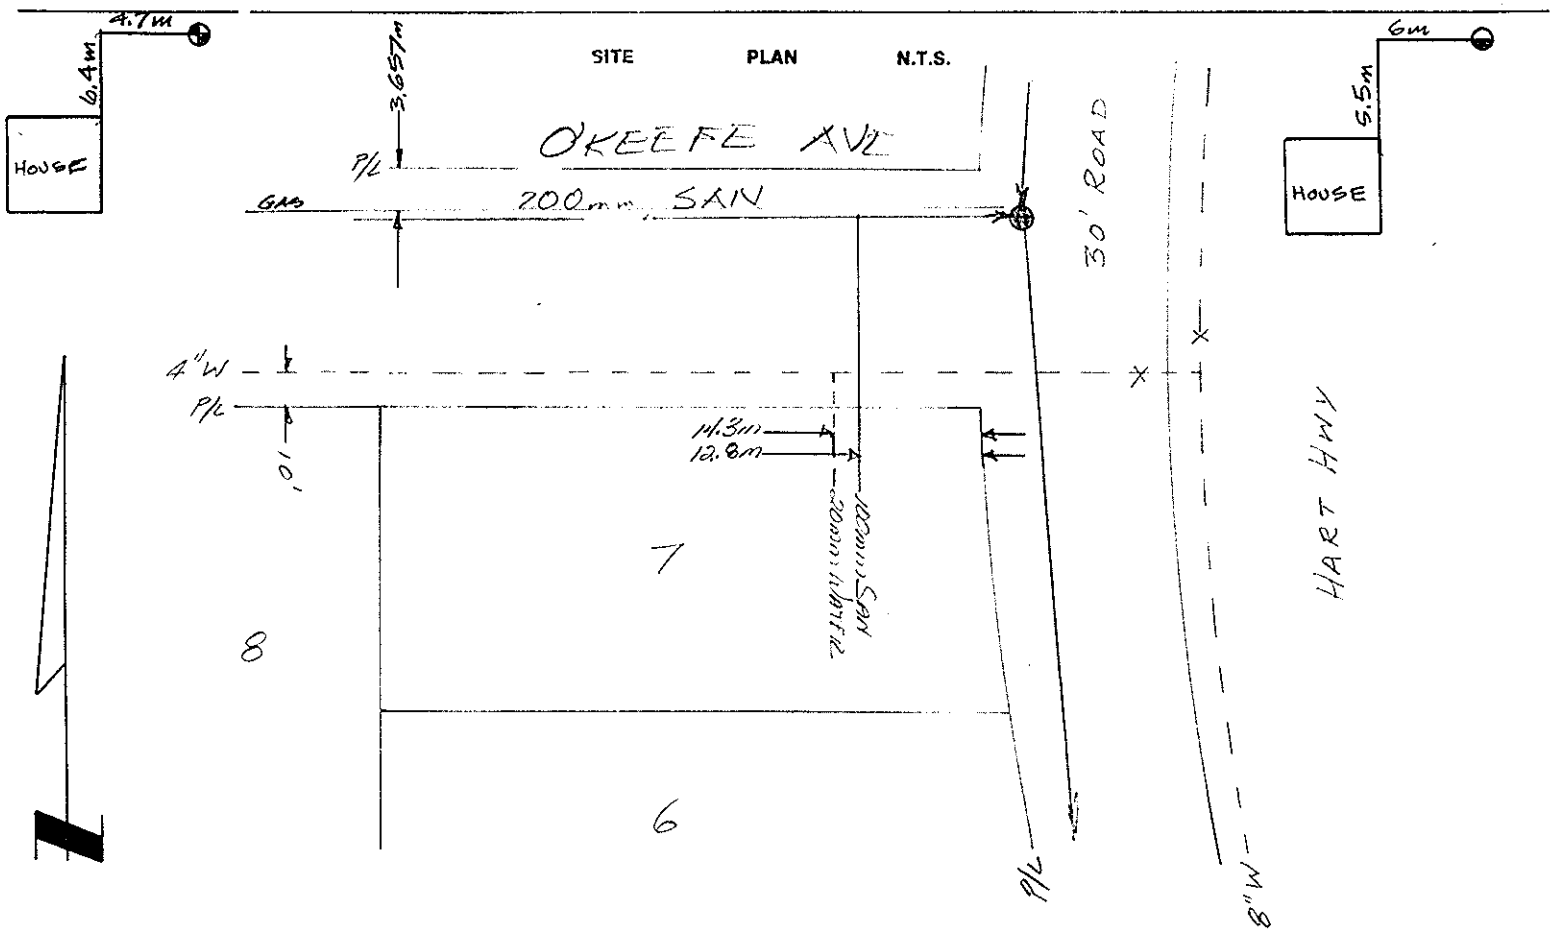
Comments: NO WATER SERVICE - NO LOCATION