City of Prince George
HISTORY SHEET

SHEET NUMBER № 0546 **Roll Number** 01294380 1

Legal: LOT'S 51 BLOCK D.L. 938 PLAN 9107

Address: 2755 HAMMOND AVE

Sanitary Connection: # 751 SIZE MATERIAL INV. CONNECTED

Water Connection # 2051 SIZE 3/4" MATERIAL Copper METER CONNECTED

Storm Connection: # SIZE MATERIAL INV. CONNECTED

Cash Receipt No's: WATER SANITARY STORM

CURB FROM PROPERTY LINE PAVEMENT WIDTH

B.C. HYDRO UNDERGROUND CONNECTION

B.C. TELEPHONE UNDERGROUND CONNECTION

INLAND GAS

Information Sheets:

Comments: SANITARY SEWER AND WATER SERVICE CONNECTIONS ARE IN A COMMON TRENCH AND TERMINATE AT THE MID-POINT OF EACH LOT. R.L.F. 6/99.
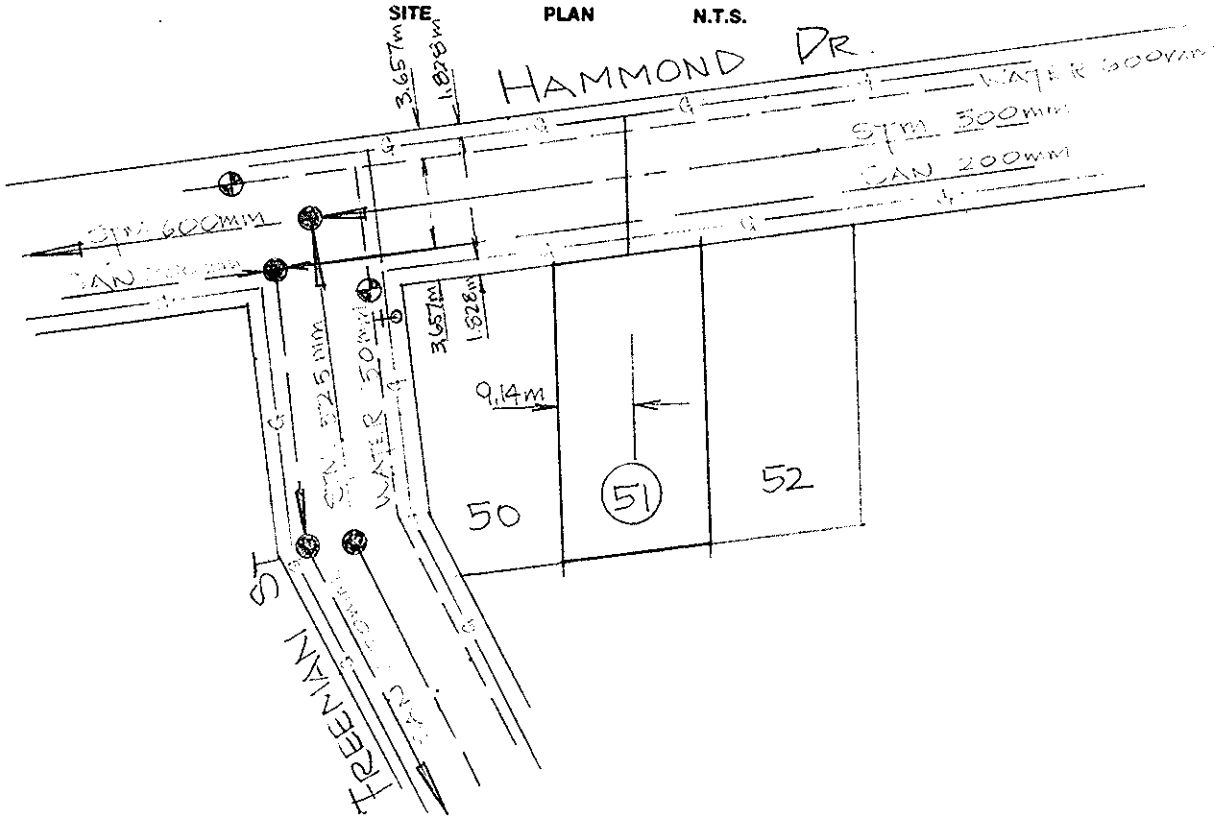
SITE PLAN N.T.S.