City of Prince George
HISTORY SHEET

012952559
012952567

SHEET NUMBER **1222** **Roll Number** 3314-000

Legal: LOT'S 1-2 BLOCK 152 D.L. 343 PLAN 1268

Address: 1385-4TH
440 BRUNSWICK ST.

Sanitary Connection: # 2416, 1308 SIZE –, – MATERIAL –, – INV. –, 1867.65 CONNECTED –, YES

Water Connection # 262 SIZE 2" MATERIAL Cu METER # 307, #20, #65 CONNECTED –

Storm Connection: # 262 SIZE 6" MATERIAL TRANSITE INV. 1873.25 CONNECTED –

Cash Receipt No's: WATER – SANITARY –, 2155 STORM 228.

CURB FROM PROPERTY LINE 10' PAVEMENT WIDTH 46'

B.C. HYDRO O.H. UNDERGROUND CONNECTION –

B.C. TELEPHONE IN LANE U.T. 165 UNDERGROUND CONNECTION –

INLAND GAS IN LANE & BRUNSWICK, 3" ϕ & 2" ϕ MAINS RESPECTIVELY

Information Sheets: 1139

Comments: THE INFORMATION CONTAINED HEREIN IS FOR INTERNAL USE ONLY. NOT TO BE RELIED UPON UNLESS CONFIRMED BY SITE INSPECTION AND/OR INVESTIGATION.
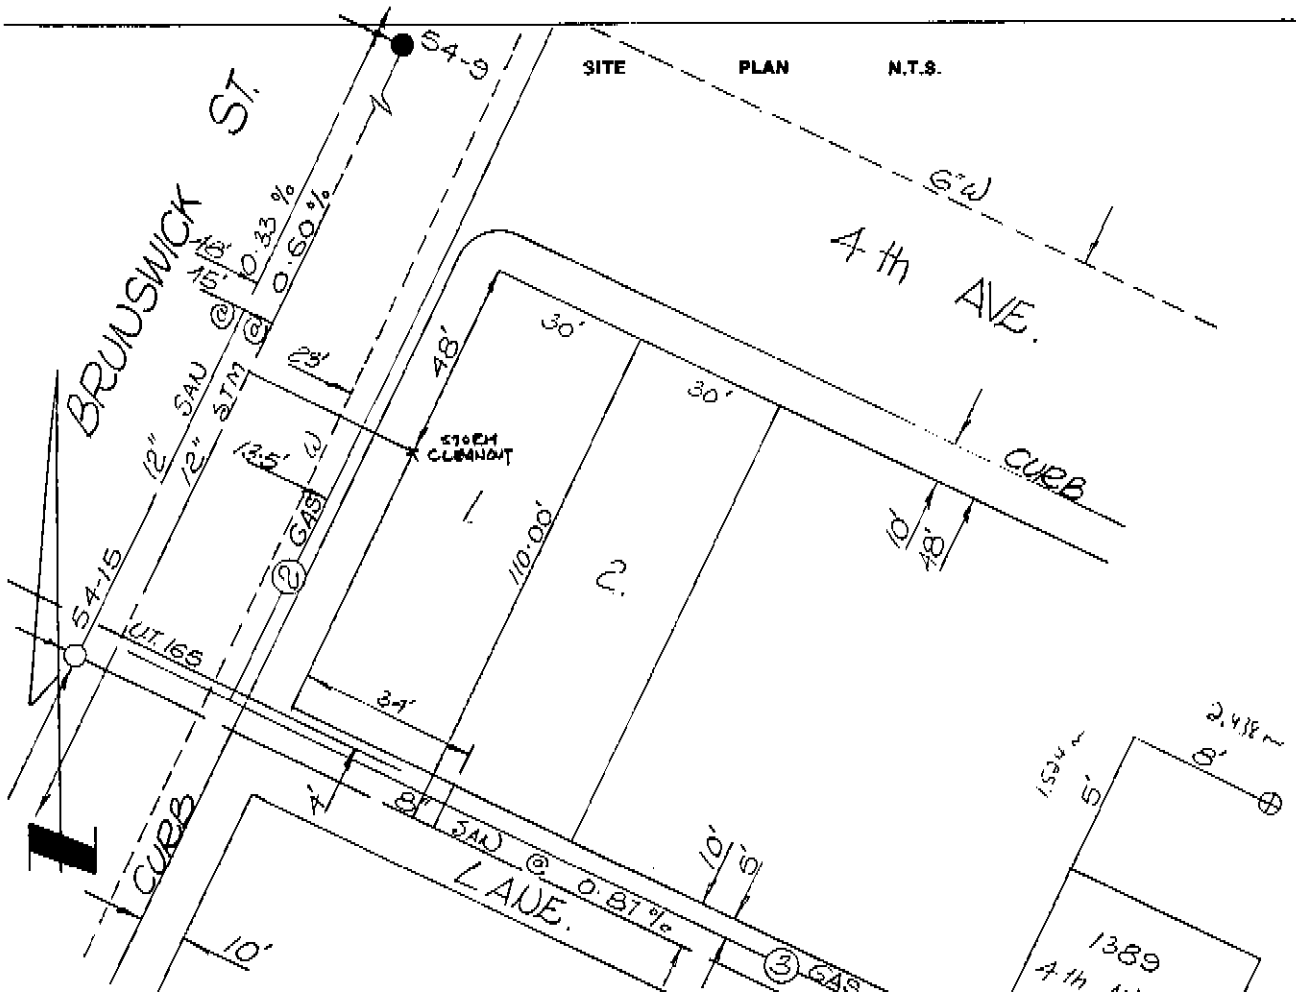
SITE PLAN N.T.S.