City of Prince George
HISTORY SHEET

012964948

SHEET NUMBER **Roll Number**

Legal: LOT'S 18 BLOCK D.L. 913 PLAN 16511

Address: 140 AITKEN CRES

Sanitary Connection: # 5674 SIZE 100mm MATERIAL AC INV. CONNECTED

Water Connection # 5674 SIZE 20mm MATERIAL CU METER CONNECTED

Storm Connection: # SIZE MATERIAL INV. CONNECTED

Cash Receipt No's: WATER SANITARY STORM

CURB FROM PROPERTY LINE PAVEMENT WIDTH

B.C. HYDRO UNDERGROUND CONNECTION

B.C. TELEPHONE UNDERGROUND CONNECTION

INLAND GAS

Information Sheets:

Comments:
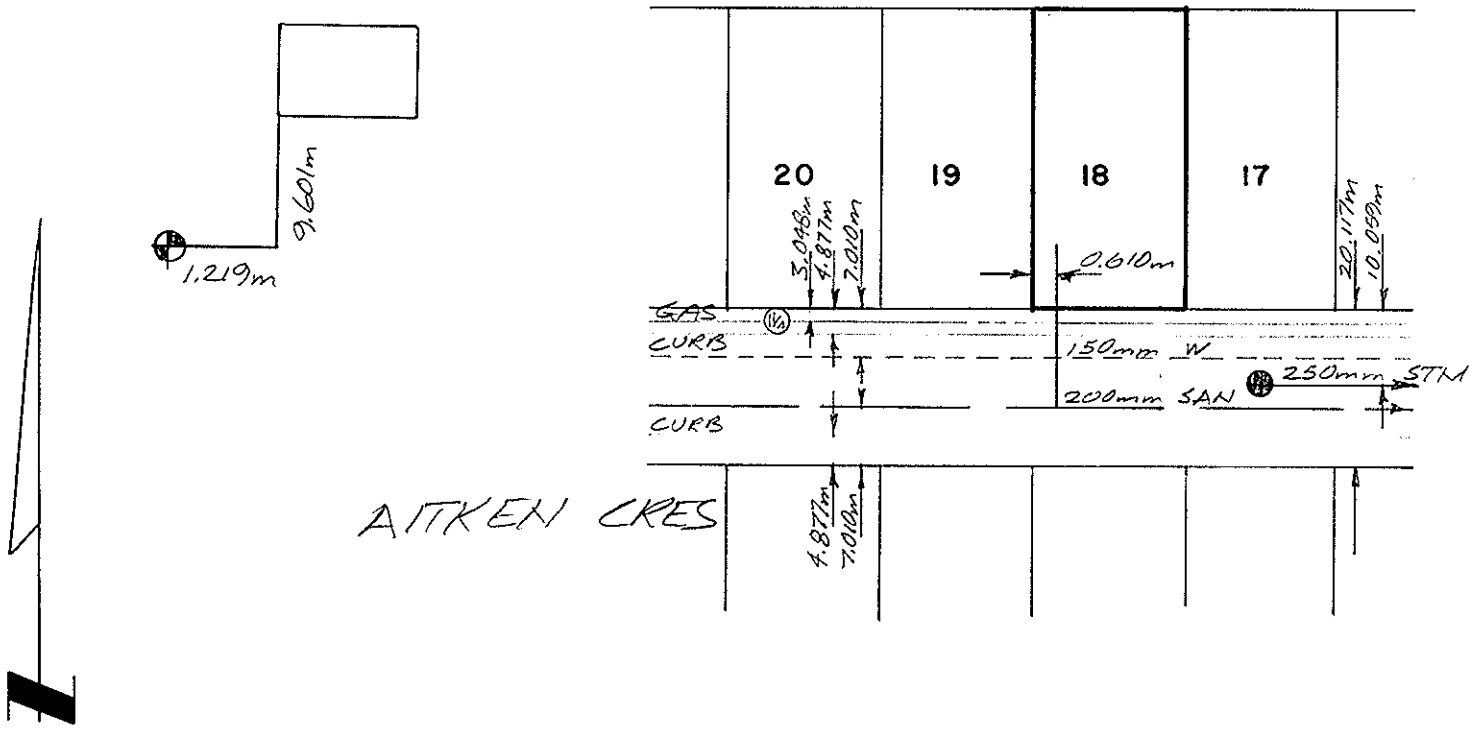
SITE PLAN N.T.S.