City of Prince George
HISTORY SHEET

SHEET NUMBER 1395 **Roll Number**

Legal: LOT'S 6-10 BLOCK 162 D.L. 343 PLAN 1268

Address: 1405 5th AVENUE

Sanitary Connection: # 1094 SIZE 4" MATERIAL A.C. INV. 1874.90 CONNECTED YES

Water Connection # 4485 SIZE 2" MATERIAL COPPER METER CONNECTED YES

Storm Connection: # 240 SIZE 8" MATERIAL A.C. INV. 1886.07 CONNECTED YES

Cash Receipt No's: WATER SANITARY STORM

CURB FROM PROPERTY LINE 10' PAVEMENT WIDTH 60'

B.C. HYDRO O.H. UNDERGROUND CONNECTION

B.C. TELEPHONE UNDERGROUND CONNECTION IN LANE N OF 6th AVE. ALONG WEST SIDE OF BRUNSWICK

INLAND GAS IN LANE ϕ 2" MAIN

Information Sheets:

Comments: BENCH MARK #24-68

ELEVATION = 1876.24 H.N. N.E. CORNER 5th AND BRUNSWICK

LEVEL BOOK # 217
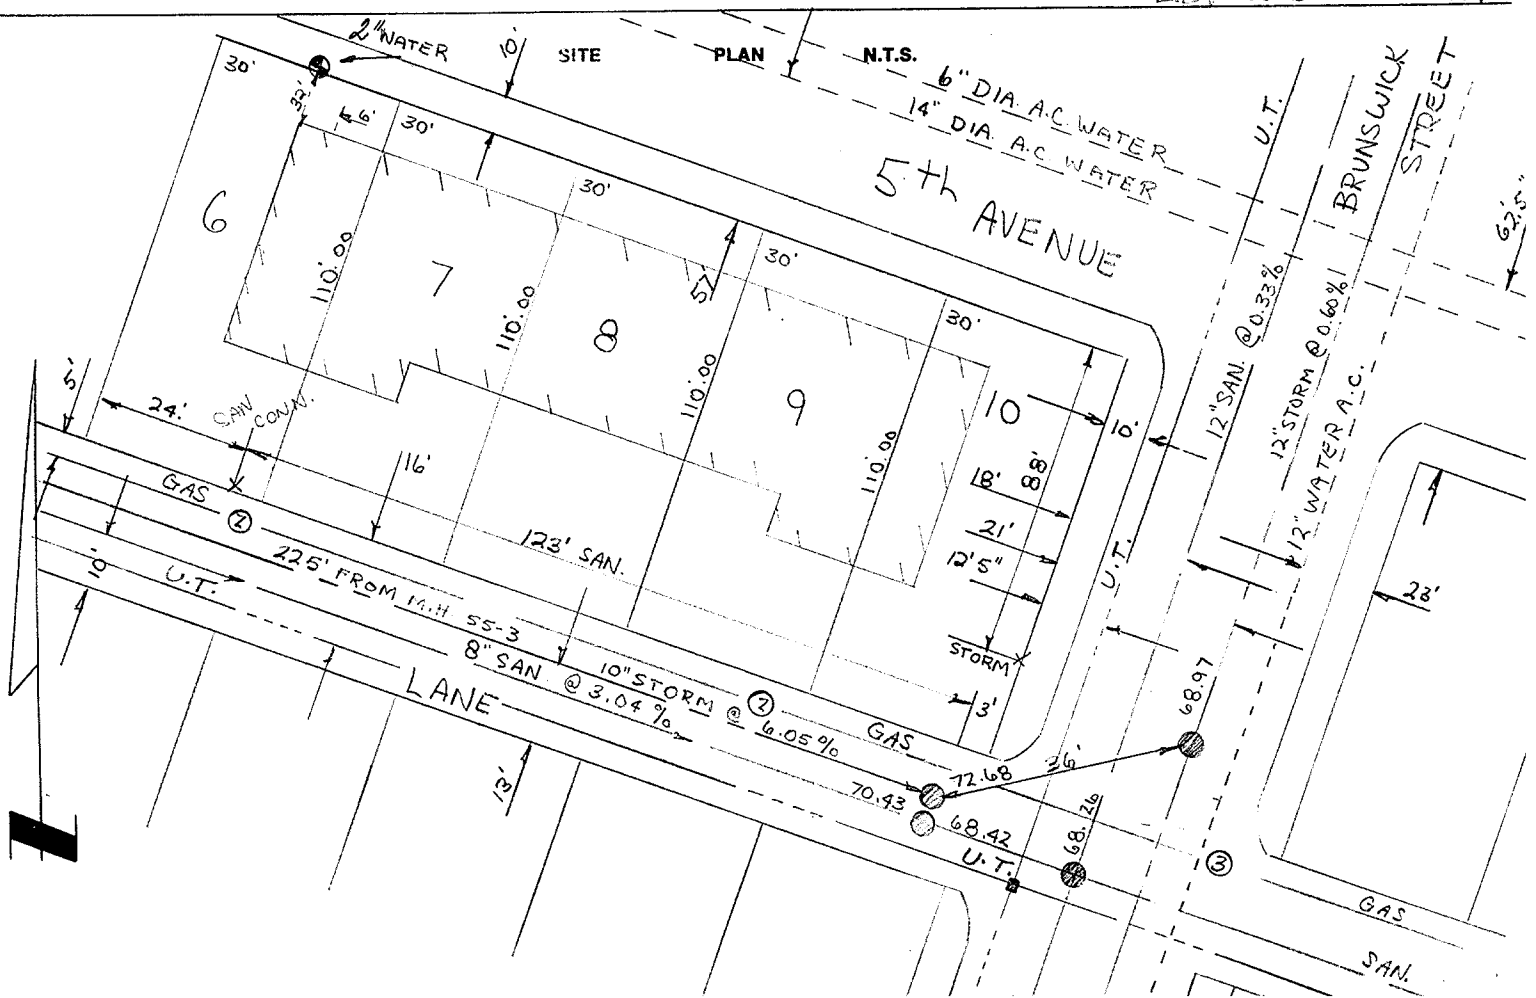
SITE PLAN N.T.S.