City of Prince George
HISTORY SHEET

0130191 71

SHEET NUMBER 1047 **Roll Number** 2900-000

Legal: LOT'S 4 BLOCK 131 D.L. 343 PLAN 1268

Address: 1467 THIRD AVE.

Sanitary Connection: # 2303 SIZE – MATERIAL – INV. – CONNECTED –

Water Connection # – SIZE MATERIAL METER CONNECTED –

Storm Connection: # – SIZE MATERIAL INV. CONNECTED –

Cash Receipt No's: WATER SANITARY – STORM

CURB FROM PROPERTY LINE 10' PAVEMENT WIDTH 60'

B.C. HYDRO O·H UNDERGROUND CONNECTION –

B.C. TELEPHONE IN LANE U.T. 165. UNDERGROUND CONNECTION

INLAND GAS IN LANE 3" ϕ MAIN.

Information Sheets: –

Comments:
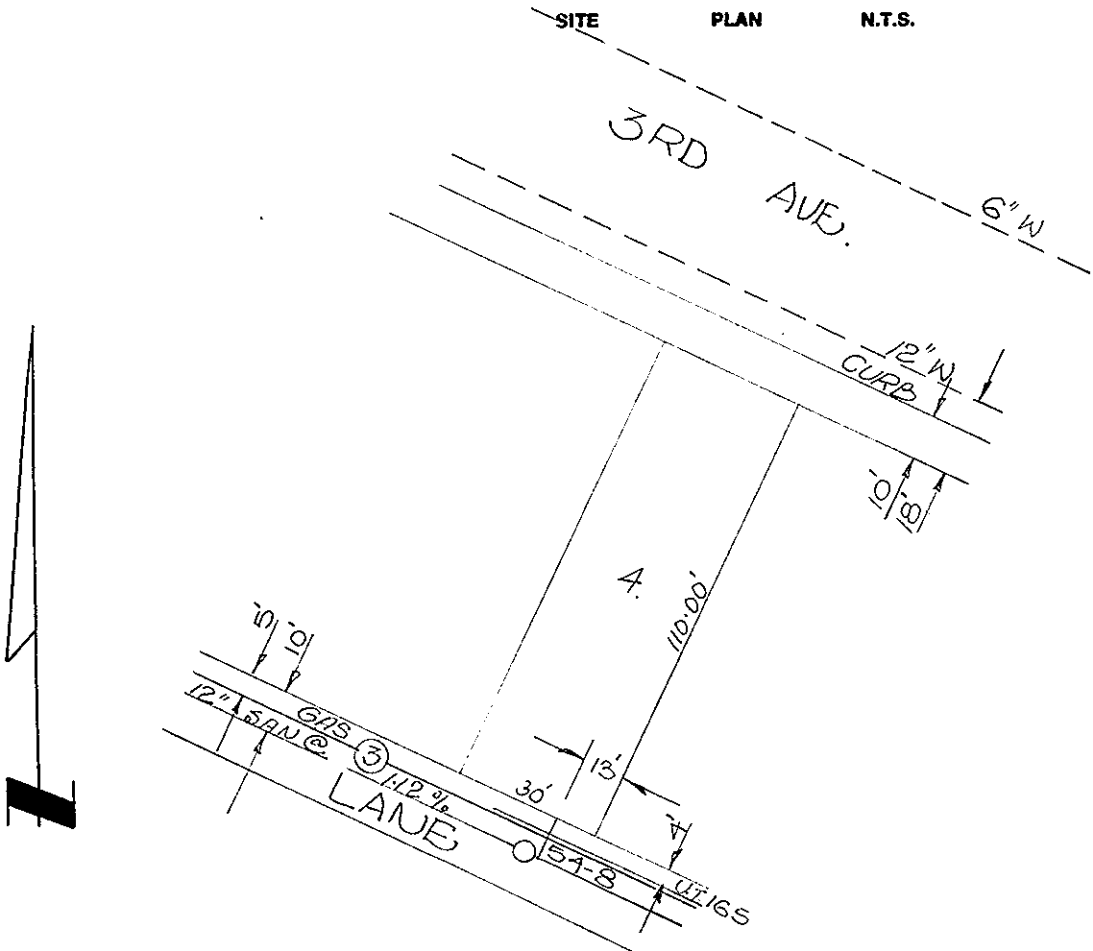
SITE PLAN N.T.S.