City of Prince George
HISTORY SHEET

013023730
013023675
013042190

SHEET NUMBER **1213** **Roll Number** 3297-000

Legal: LOT'S 4-6 BLOCK 151 D.L. 343 PLAN 1268

Address: 1249-59 4th AVE.

Sanitary Connection: # 2402, 2403, 2404 SIZE -,-,- MATERIAL -,-,- INV. -,-,- CONNECTED -,-,-

Water Connection # 3778 SIZE 1" MATERIAL Cu METER # 100 CONNECTED -

Storm Connection: # - SIZE MATERIAL INV. CONNECTED -

Cash Receipt No's: WATER 1980 SANITARY -,-,- STORM

CURB FROM PROPERTY LINE 10' PAVEMENT WIDTH 46'

B.C. HYDRO O.H UNDERGROUND CONNECTION -

B.C. TELEPHONE O.H UNDERGROUND CONNECTION -

INLAND GAS (N) LANE 3" ϕ MAIN.

Information Sheets: 1905, 249, 221.

Comments:
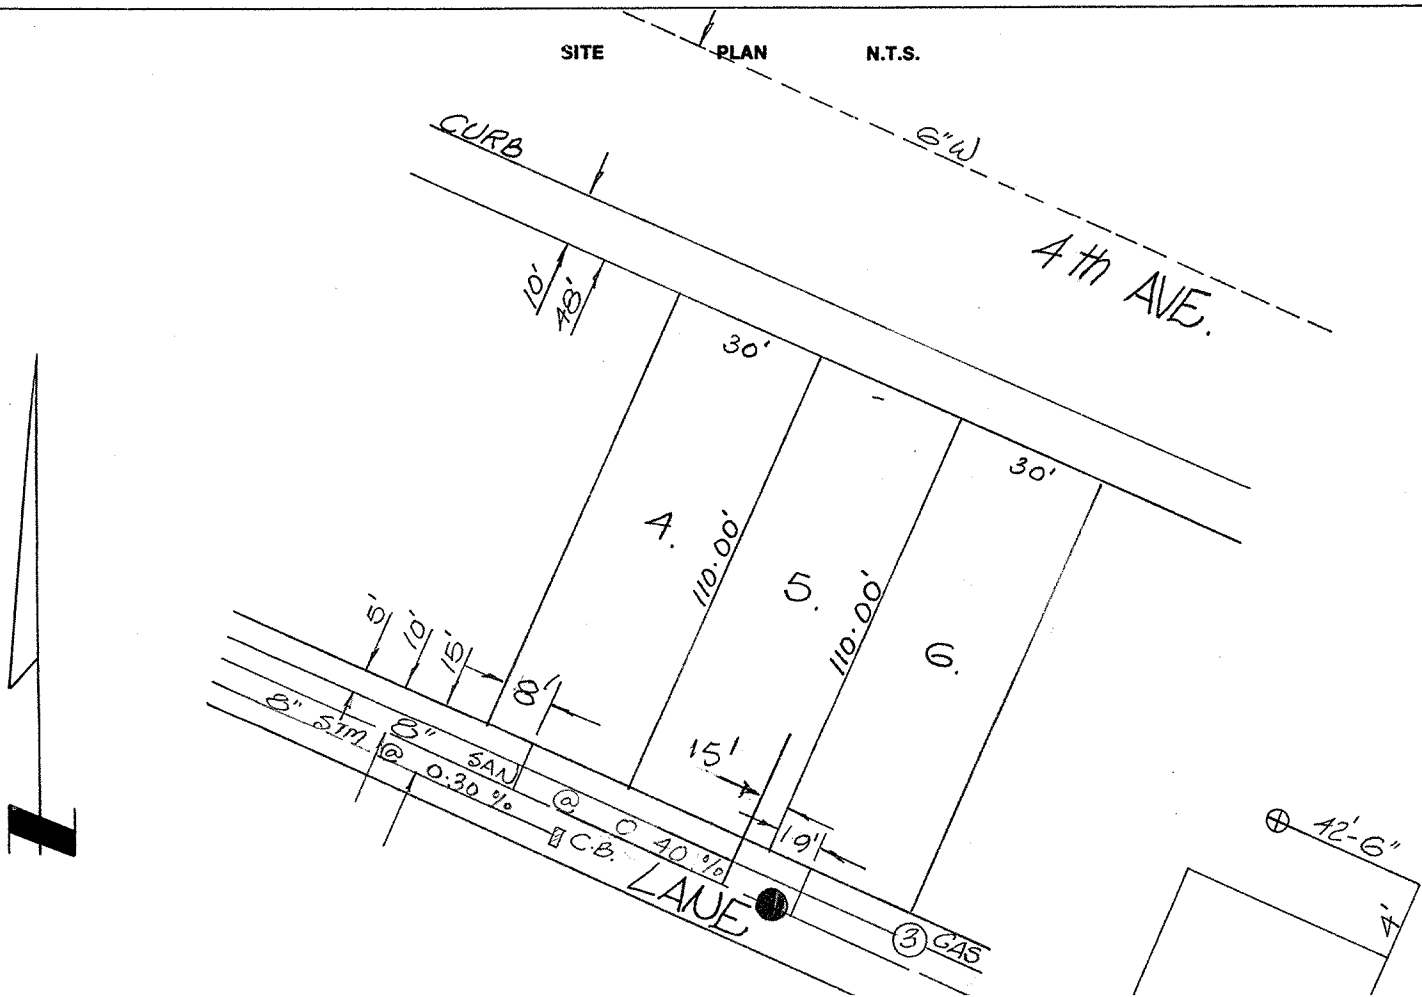
SITE PLAN N.T.S.