City of Prince George

# History Sheet

| | |
|---|---|
| PID: | 013030141 |
| | 013030175 |
| SD/MU: | |
| WO: | |

Civic Address: 2453 McBride Cres

Legal Description: Lot: 34, 35 Block: 115 District Lot: 343 Plan: 1268

| Service Type | Diameter (mm) | Material | Invert Elev at main (m) | Invert Elev at property line (m) | Invert Depth at service end (m) | Distance into property (m) | Installation Date |
|---|---|---|---|---|---|---|---|
| Sanitary | 100mm | AC | - | 586.46 | 2.17 | - | December 1956 |
| Water | 20mm | Copper | - | - | - | - | December 1956 |
| Storm | N/A | N/A | - | - | - | - | |

| Service Connection Location | | | | Sanitary (m) | Storm (m) |
|---|---|---|---|---|---|
| Distance from downstream San MH | 3069 | towards upstream San MH | 3072 | 53.07 | |
| Distance from downstream Stm MH | - | towards upstream Stm MH | - | | |

| Power | Size | Communications | Size | Cable | Size | Gas | Size |
|---|---|---|---|---|---|---|---|
| BC Hydro | - | Telus | - | Shaw | - | FortisBC | - |
| Overhead Service | | Overhead Service | | Overhead Service | | | |

| | | |
|---|---|---|
| Installed by: | Survey Date: | - |
| Comments: | | |
| | | |
| | | |

**NOT TO SCALE The information contained herein is for internal use only.**
**Not to be relied on unless confirmed by site inspection and/or investigation.**

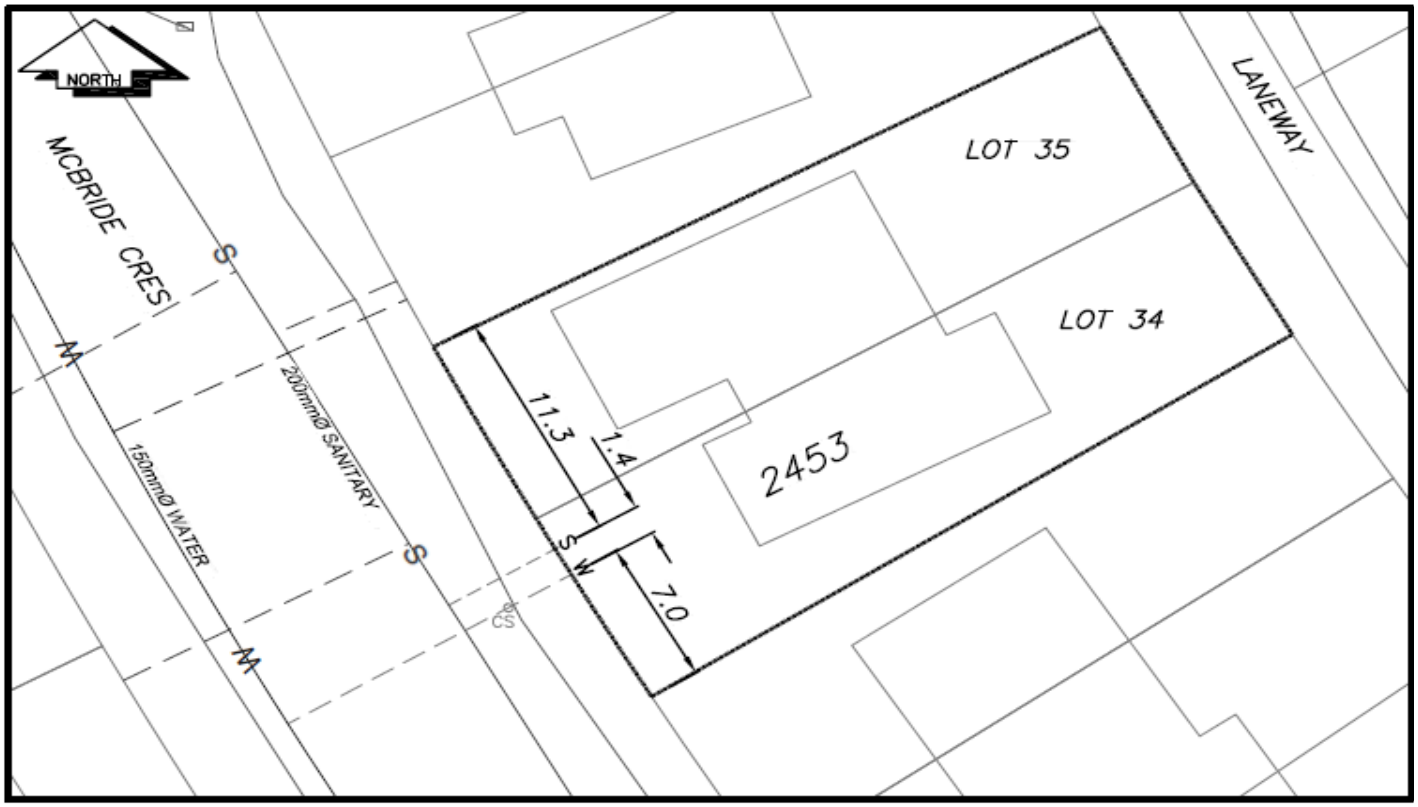


LEGEND:

| | | | | | |
|---|---|---|---|---|---|
| CS | CURB STOP | W | WATER SERVICE | D | STORM SERVICE |
| CO | CLEAN OUT | S | SANITARY SERVICE | G | GAS |
| | WATER VALVE | | FIRE HYDRANT | | ENCUMBERANCE |

**NOT TO SCALE**