City of Prince George
HISTORY SHEET

013034065
013034081

SHEET NUMBER **920** **Roll Number** 2614-000

Legal: LOT'S 10-11 BLOCK 121 D.L. 343 PLAN 1268

Address: 2117 LAURIER CR. PRINCE GEORGE, BC. 2152-6 MC. BRIDE CR.

Sanitary Connection: # 4498 SIZE 4" MATERIAL ACS. INV. 1927.51 CONNECTED YES.

Water Connection # 2750 SIZE 3/4" MATERIAL Cu METER - CONNECTED -

Storm Connection: # - SIZE MATERIAL INV. CONNECTED -

Cash Receipt No's: WATER - SANITARY 2700 STORM

CURB FROM PROPERTY LINE 16' PAVEMENT WIDTH 34'

B.C. HYDRO O.H UNDERGROUND CONNECTION -

B.C. TELEPHONE O.H. UNDERGROUND CONNECTION -

INLAND GAS IN LANE, 2" ϕ MAIN.

Information Sheets: -

Comments:

THE INFORMATION CONTAINED HEREIN IS FOR INTERNAL USE ONLY. NOT TO BE RELIED UPON UNLESS CONFIRMED BY SITE INSPECTION AND/OR INVESTIGATION.
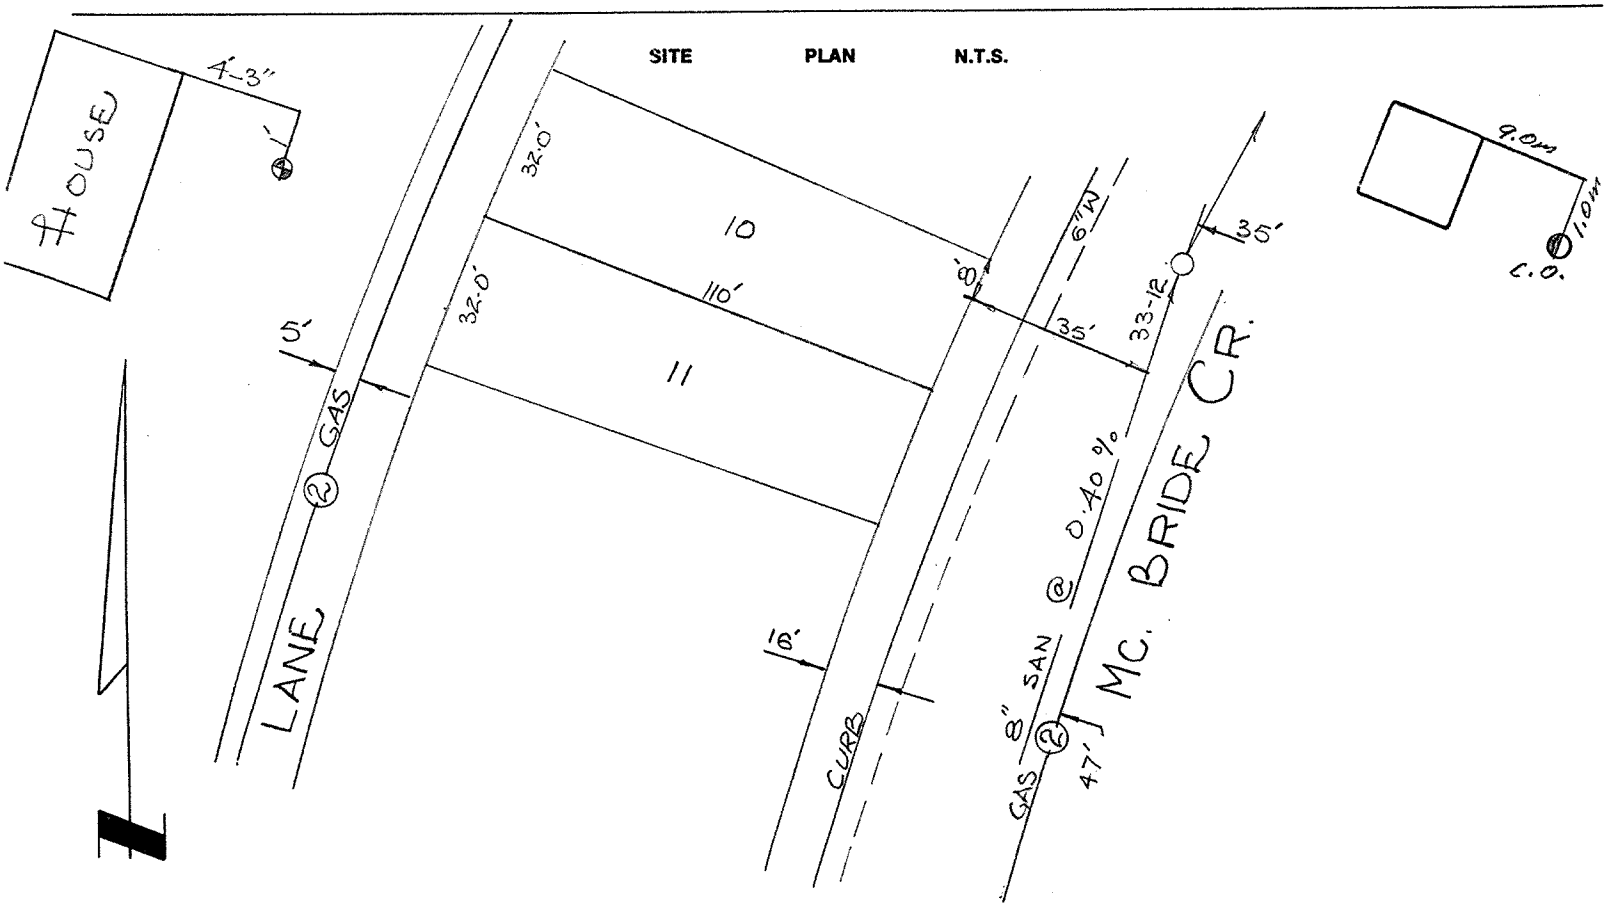
SITE PLAN N.T.S.