013205412
013205421

City of Prince George
HISTORY SHEET

SHEET NUMBER 598 **Roll Number** 1713-000

Legal: LOT'S 5-6 BLOCK 80 D.L. 343 PLAN 1268

Address: MILLER VERONICA C 853 BURDEN ST. PRINCE GEORGE, B.C. 853 BURDEN ST.

Sanitary Connection: # 404 SIZE – MATERIAL – INV. 1922.20 CONNECTED Yes.

Water Connection # 10075 SIZE 3/4" MATERIAL COPPER METER CONNECTED –

Storm Connection: # – SIZE MATERIAL INV. CONNECTED –

Cash Receipt No's: WATER SANITARY 1126 STORM

CURB FROM PROPERTY LINE – PAVEMENT WIDTH –

B.C. HYDRO O.H. UNDERGROUND CONNECTION –

B.C. TELEPHONE O.H UNDERGROUND CONNECTION –

INLAND GAS IN LANE 6" Ø MAIN.

Information Sheets: –

Comments:
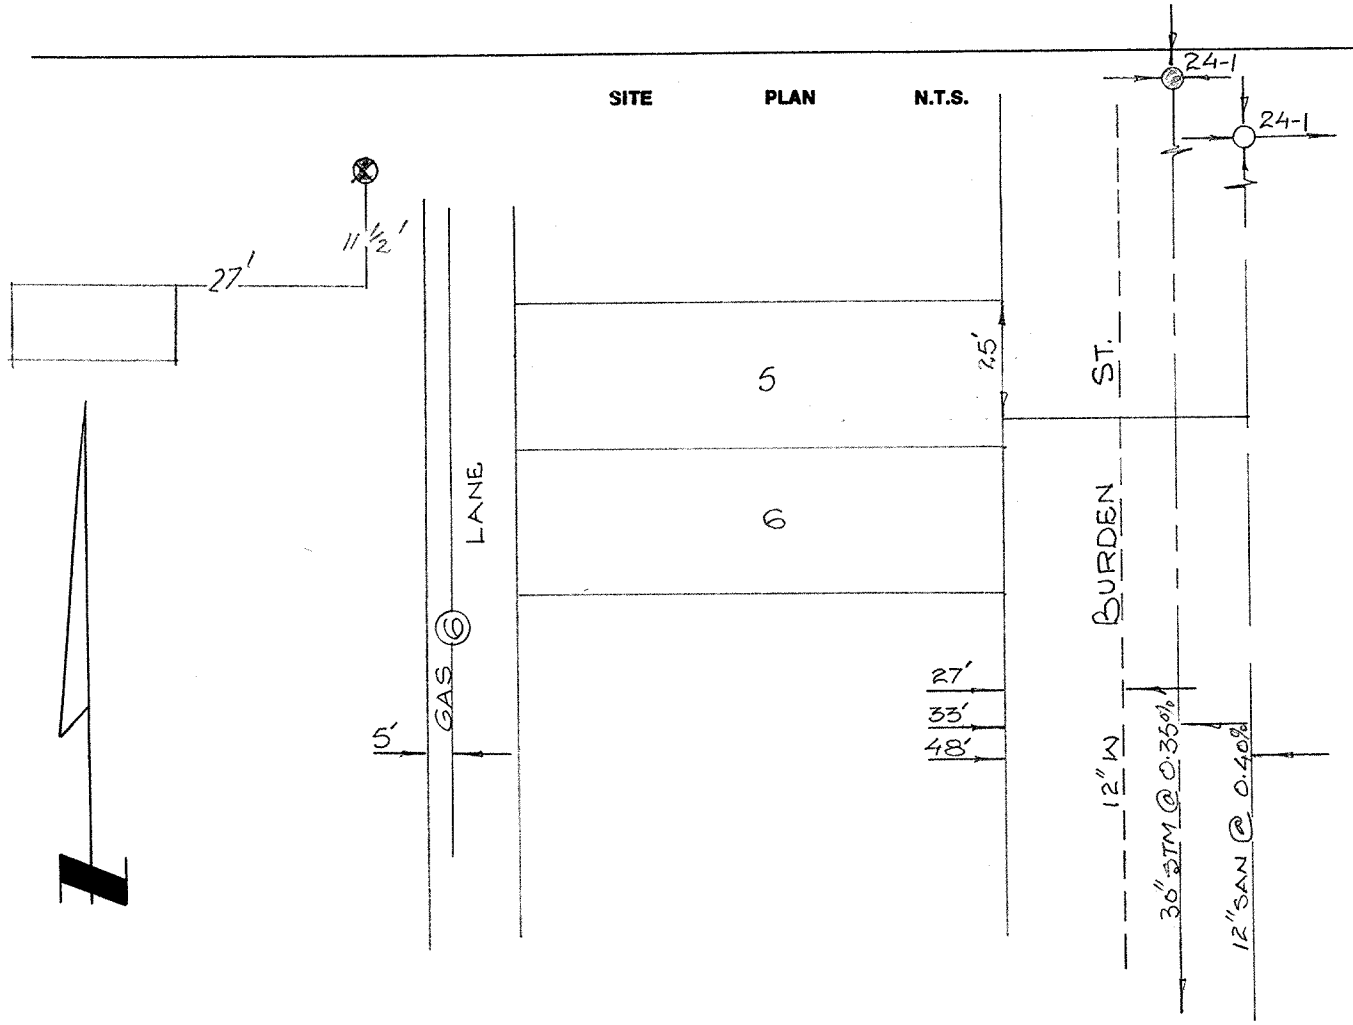
SITE PLAN N.T.S.