City of Prince George
HISTORY SHEET

313212087

SHEET NUMBER № 2949 **Roll Number**

Legal: LOT'S 22 BLOCK D.L. 343 PLAN 19876

Address: 1784 YEW STREET

Sanitary Connection: # 7241 SIZE MATERIAL INV. CONNECTED

Water Connection # 7243 SIZE 3/4" MATERIAL METER CONNECTED

Storm Connection: # SIZE MATERIAL INV. CONNECTED

Cash Receipt No's: WATER SANITARY STORM

CURB FROM PROPERTY LINE PAVEMENT WIDTH

B.C. HYDRO UNDERGROUND CONNECTION

B.C. TELEPHONE UNDERGROUND CONNECTION

INLAND GAS

Information Sheets:

Comments:

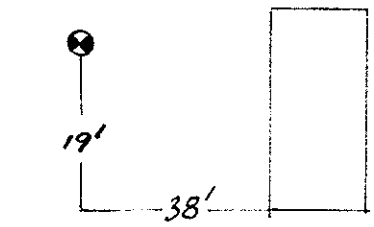
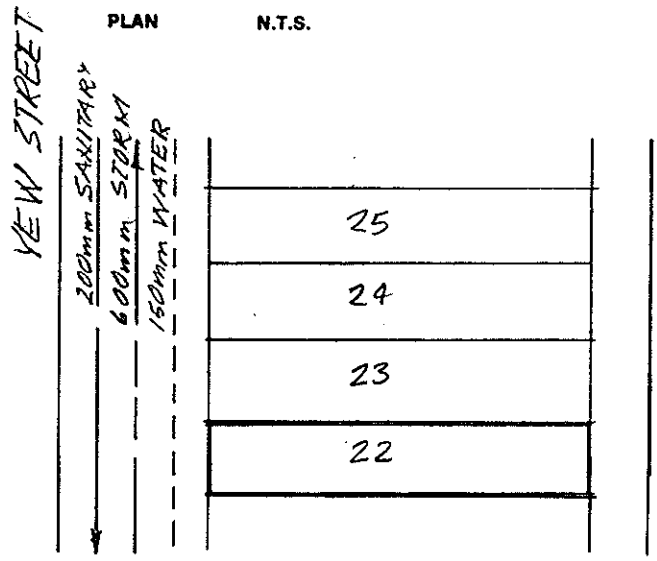
SITE PLAN N.T.S.