# City of Prince George
## HISTORY SHEET

SHEET NUMBER 11799 **Roll Number** 013289632

**Legal:** LOT'S 13 BLOCK D.L. 3050 PLAN 8332

**Address:** 930 N-NECHAKO RD.

**Sanitary Connection:** # SIZE 100mm MATERIAL PVC INV. CONNECTED

**Water Connection** # SIZE 20 mm MATERIAL COPPER METER CONNECTED

**Storm Connection:** # SIZE MATERIAL INV. CONNECTED

**Cash Receipt No's:** WATER SANITARY 13011 STORM

CURB FROM PROPERTY LINE NO CURB PAVEMENT WIDTH 12.500m

B.C. HYDRO O/H UNDERGROUND CONNECTION

B.C. TELEPHONE O/H UNDERGROUND CONNECTION

INLAND GAS AS SHOWN

**Information Sheets:**

**Comments:**
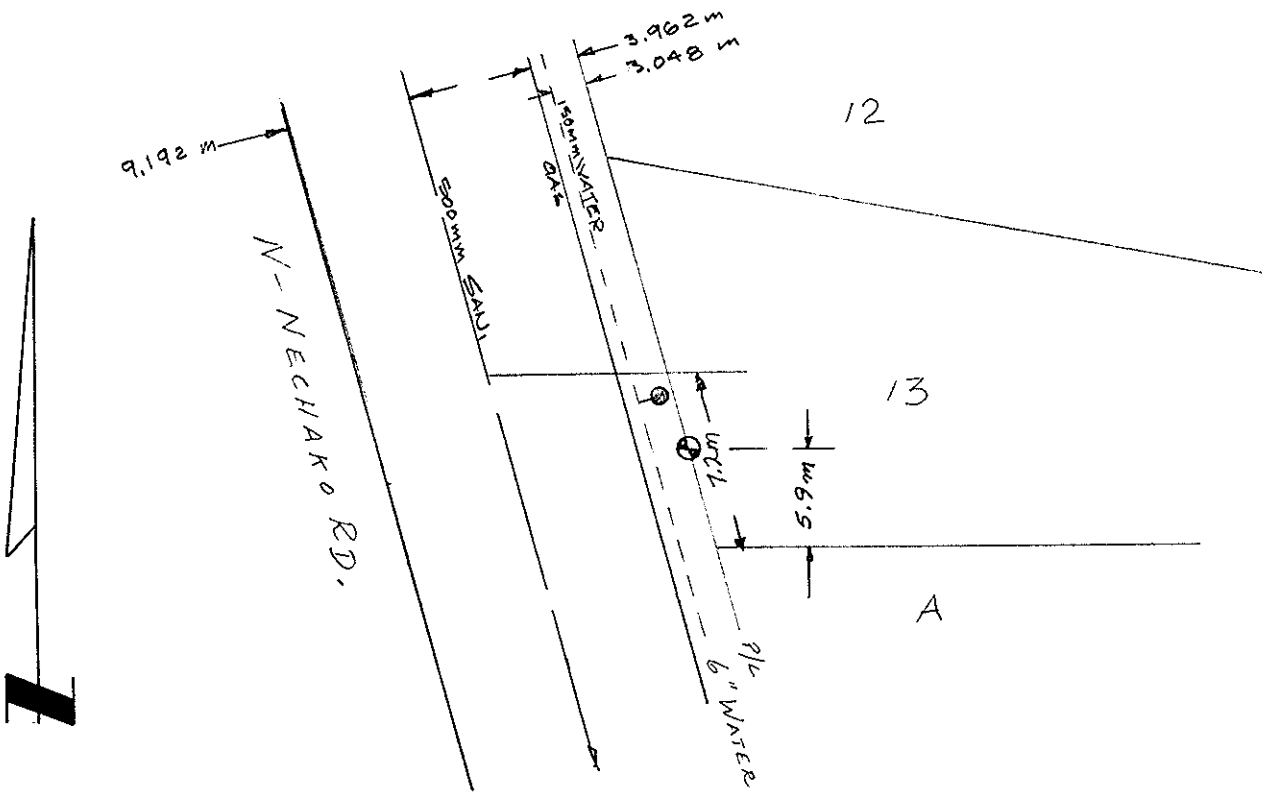
SITE PLAN N.T.S.