City of Prince George
HISTORY SHEET

SHEET NUMBER 10878 **Roll Number** 513299964

Legal: LOT'S 17 BLOCK D.L. 4377 PLAN 8233

Address: 1862 MAC ANDREW

Sanitary Connection: # 131146 SIZE 4" MATERIAL INV. 2128.88 CONNECTED

Water Connection # SIZE 20mm MATERIAL Cu METER CONNECTED

Storm Connection: # SIZE MATERIAL INV. CONNECTED

Cash Receipt No's: WATER SANITARY 1799 STORM

CURB FROM PROPERTY LINE PAVEMENT WIDTH

B.C. HYDRO UNDERGROUND CONNECTION

B.C. TELEPHONE UNDERGROUND CONNECTION

INLAND GAS

Information Sheets:

Comments: HIC WATER SERVICE - 30' EAST OF S.E. CORNER OF HOUSE & 15' SOUTH OF HOUSE
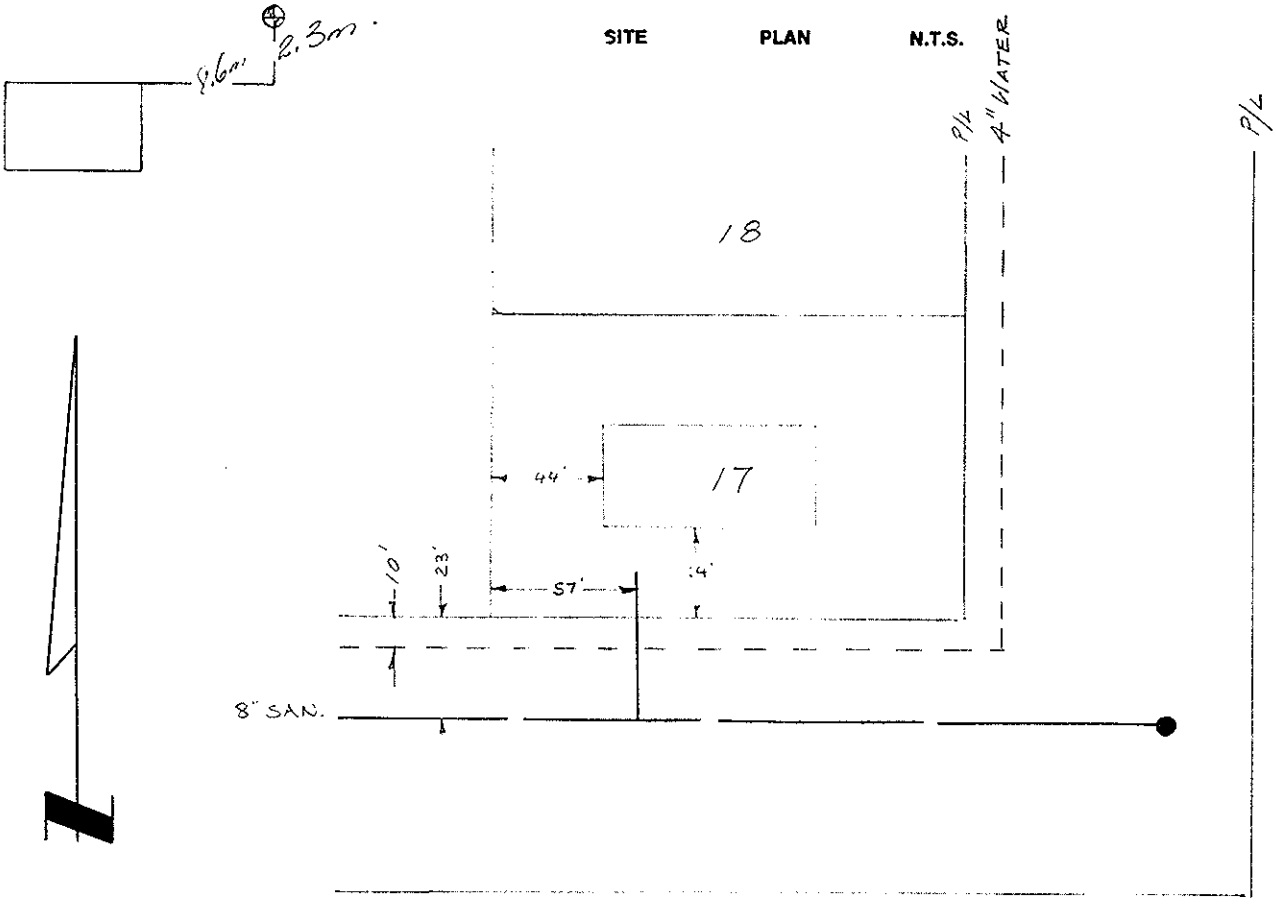
SITE PLAN N.T.S.