City of Prince George
HISTORY SHEET

(1) 013322770 S
013322788

SHEET NUMBER **Roll Number** 013322818

Legal: LOT'S 6-7-S½ 8 BLOCK 7 D.L. 2610 PLAN 847

Address: 153 Quinn St

Sanitary Connection: # 4263 SIZE no info MATERIAL INV. CONNECTED

Water Connection # SIZE 20mm MATERIAL Cu METER CONNECTED

Storm Connection: # SIZE MATERIAL INV. CONNECTED

Cash Receipt No's: WATER SANITARY STORM

CURB FROM PROPERTY LINE PAVEMENT WIDTH

B.C. HYDRO UNDERGROUND CONNECTION

B.C. TELEPHONE UNDERGROUND CONNECTION

INLAND GAS

Information Sheets:

Comments:
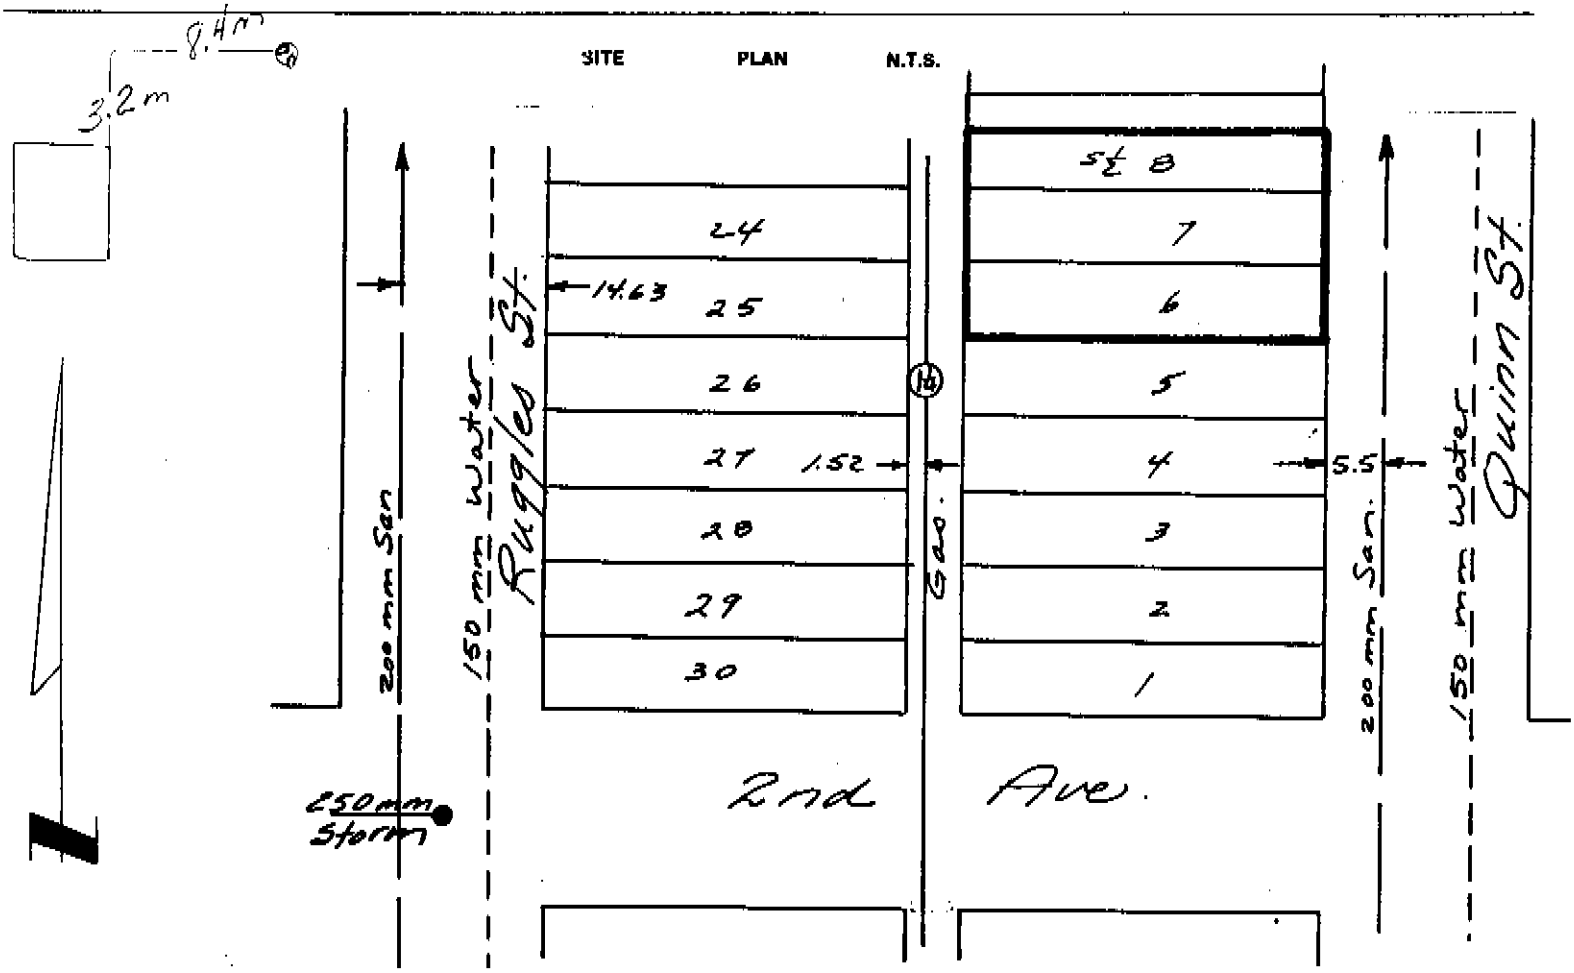
SITE PLAN N.T.S.