City of Prince George
HISTORY SHEET

SHEET NUMBER № 1140 **Roll Number** 013584294

Legal: LOT'S A BLOCK D.L. 1429 PLAN 5796

Address: 802 JOHNSON ST.

Sanitary Connection: # 1919 SIZE MATERIAL INV. CONNECTED

Water Connection # 1629 SIZE 13mm MATERIAL COPPER METER CONNECTED

Storm Connection: # SIZE MATERIAL INV. CONNECTED

Cash Receipt No's: WATER SANITARY 305 STORM

CURB FROM PROPERTY LINE PAVEMENT WIDTH

B.C. HYDRO UNDERGROUND CONNECTION

B.C. TELEPHONE UNDERGROUND CONNECTION

INLAND GAS

Information Sheets:

Comments:
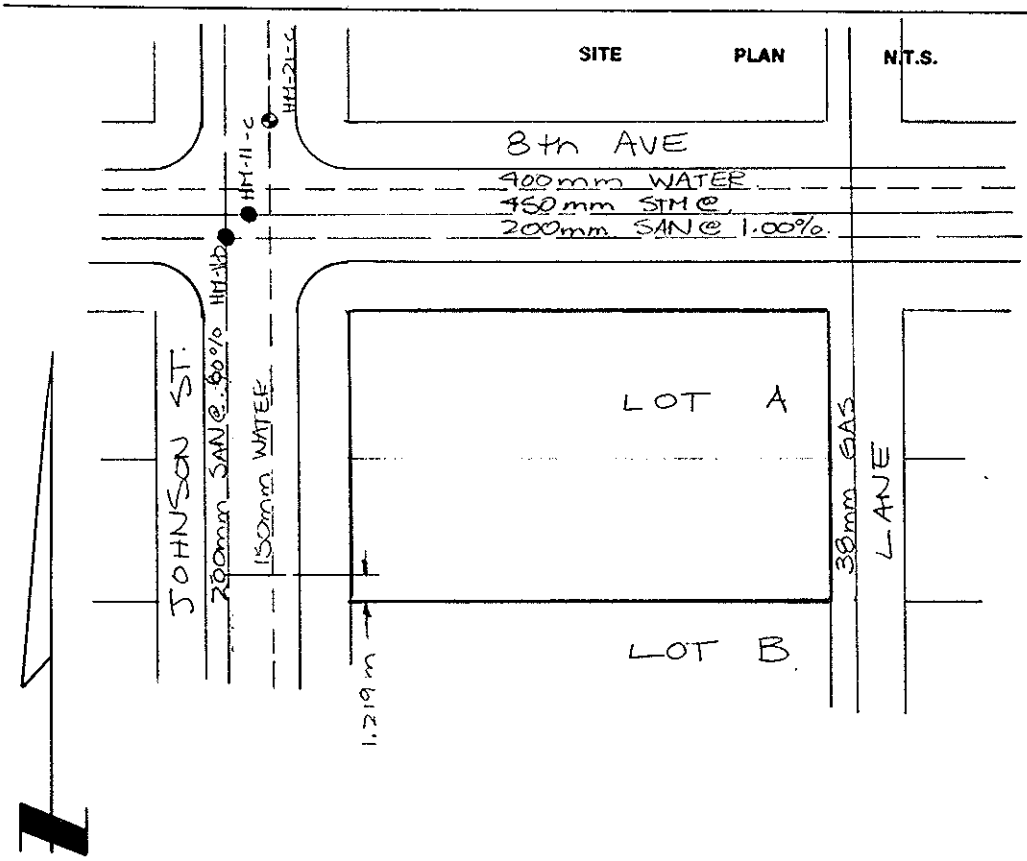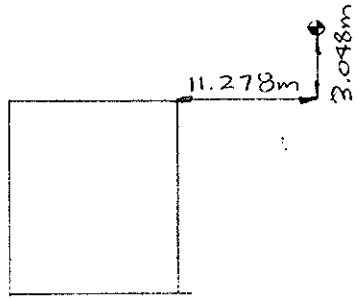
SITE PLAN N.T.S.