City of Prince George
HISTORY SHEET

SHEET NUMBER № 2763 **Roll Number** 013687697

Legal: LOT'S 1 BLOCK D.L. 1433 PLAN 9947

Address: 2852 ANDRES RD

Sanitary Connection: # 1406 SIZE 100mm MATERIAL INV. CONNECTED

Water Connection # 1406 SIZE 20mm MATERIAL COPPER METER CONNECTED

Storm Connection: # SIZE MATERIAL INV. CONNECTED

Cash Receipt No's: WATER SANITARY STORM

CURB FROM PROPERTY LINE PAVEMENT WIDTH

B.C. HYDRO UNDERGROUND CONNECTION

B.C. TELEPHONE UNDERGROUND CONNECTION

INLAND GAS

Information Sheets:
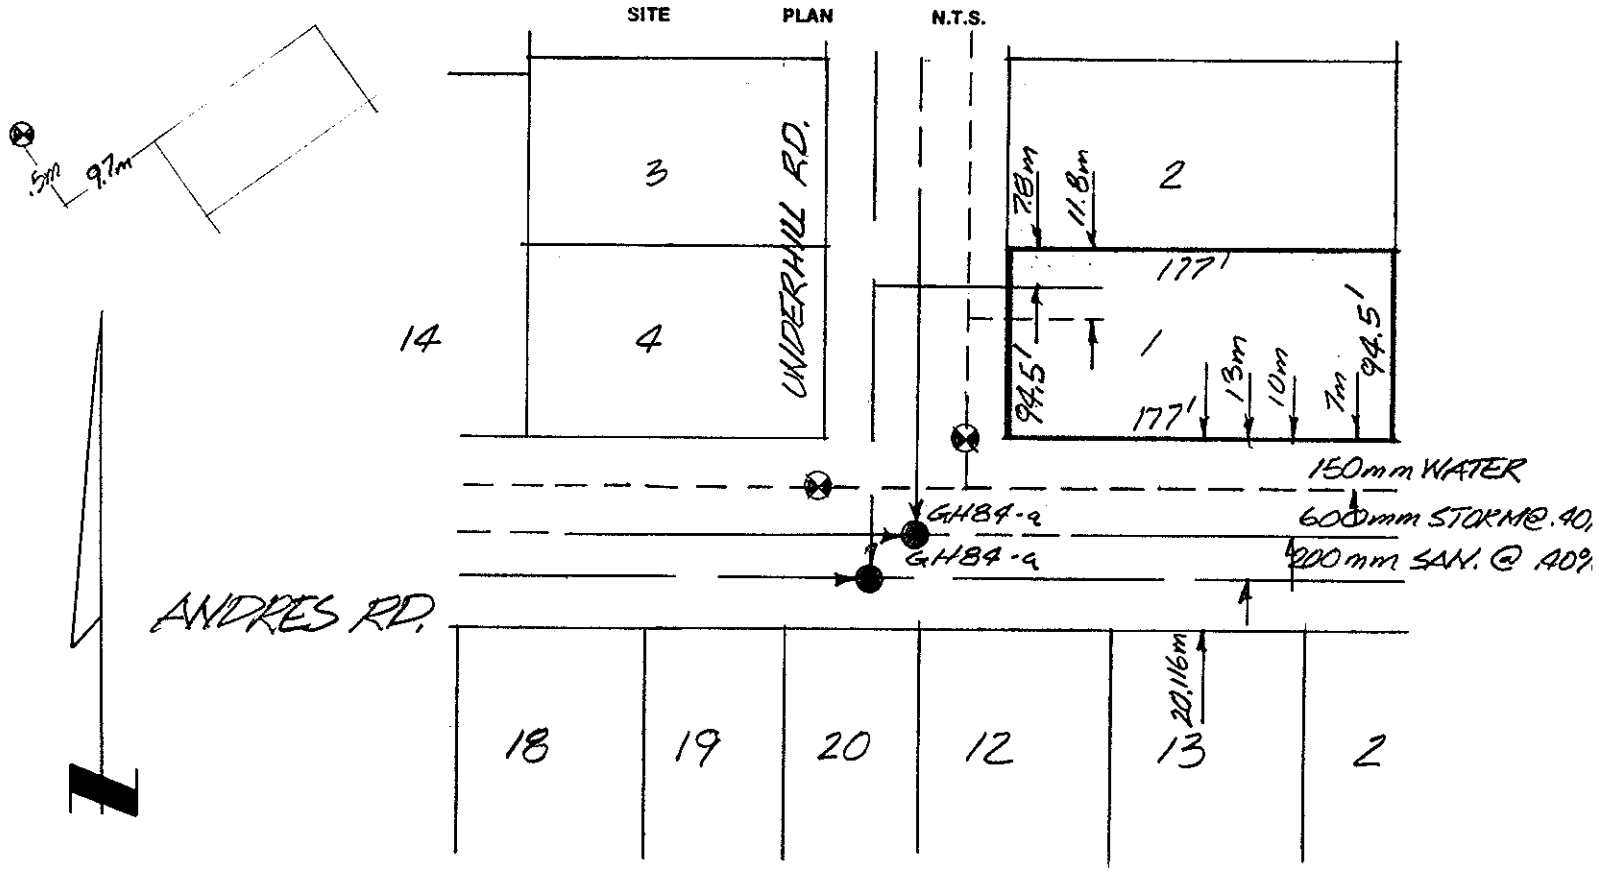
Comments: