013881 310 JK

City of Prince George
HISTORY SHEET

Refer to 1974 SFG Assessment

SHEET NUMBER **8070** **Roll Number** 143

Legal: LOT'S 7 - BLOCK 29 D.L. 417 PLAN 1409

Address: H Burgoyne 2391 ~~2395~~ Royal

Sanitary Connection: # 107 SIZE 4" MATERIAL AC INV. 107 CONNECTED

Water Connection # SIZE 20mm MATERIAL COPPER METER CONNECTED

Storm Connection: # SIZE MATERIAL INV. CONNECTED

Cash Receipt No's: 5898 WATER SANITARY ✓ paid STORM

CURB FROM PROPERTY LINE PAVEMENT WIDTH

B.C. HYDRO OH UNDERGROUND CONNECTION

B.C. TELEPHONE OH UNDERGROUND CONNECTION

INLAND GAS

Information Sheets:

Comments: vacant land
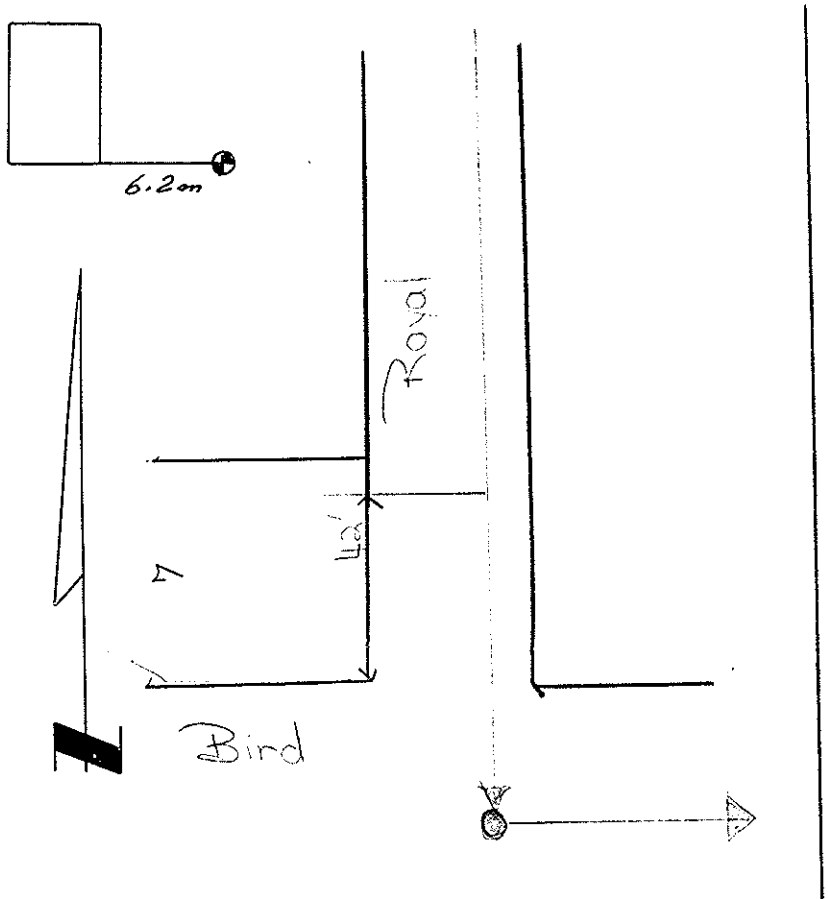
SITE PLAN N.T.S.