DS

# City of Prince George
## HISTORY SHEET

0140031 55

SHEET NUMBER 11884 **Roll Number**

**Legal:** LOT'S 2 BLOCK D.L. 2166 PLAN 1026

**Address:** 625 HOFFERCAMP RD.

**Sanitary Connection:** # SIZE MATERIAL INV. CONNECTED

**Water Connection** # SIZE MATERIAL METER CONNECTED

**Storm Connection:** # SIZE MATERIAL INV. CONNECTED

**Cash Receipt No's:** WATER SANITARY STORM

CURB FROM PROPERTY LINE PAVEMENT WIDTH

B.C. HYDRO UNDERGROUND CONNECTION

B.C. TELEPHONE UNDERGROUND CONNECTION

INLAND GAS

**Information Sheets:**

**Comments:**
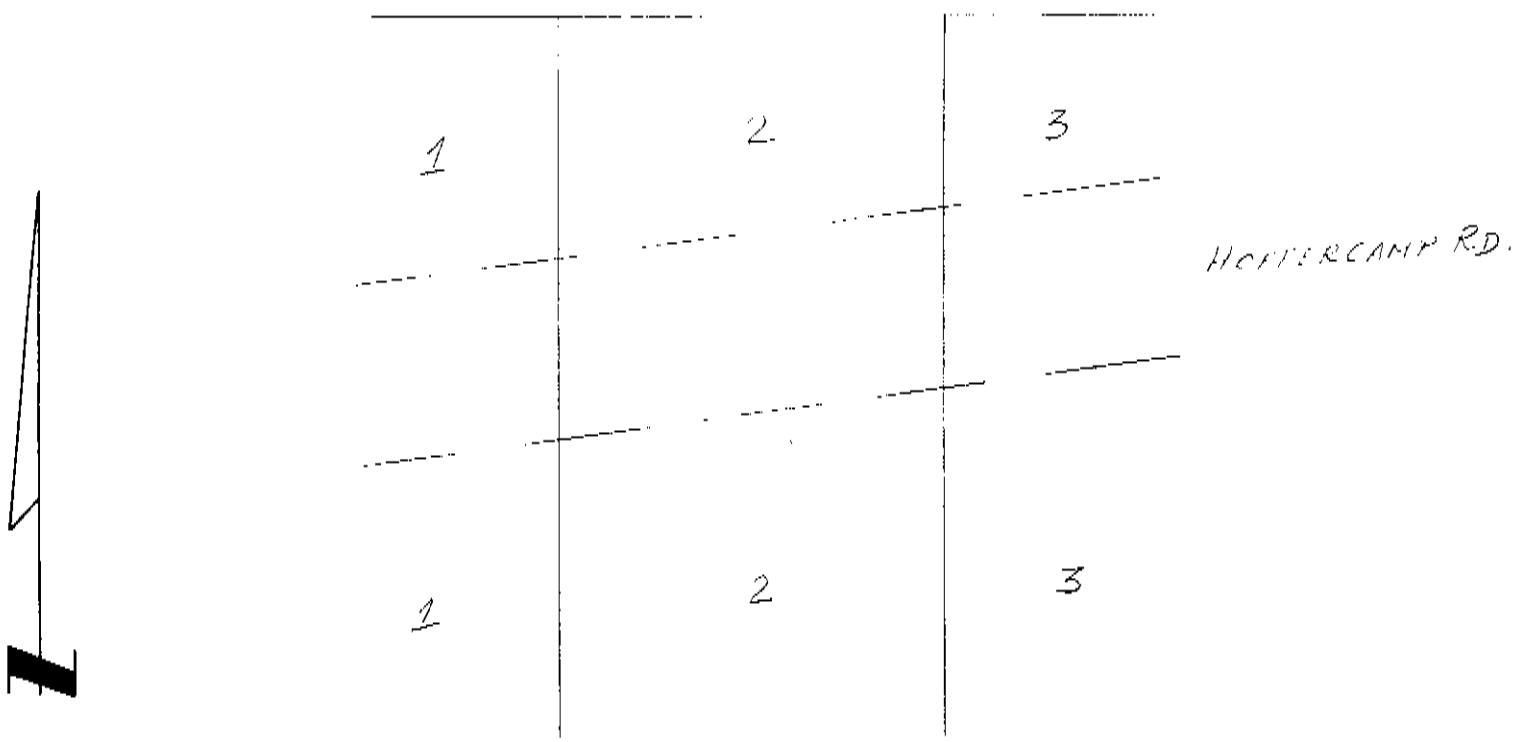
**SITE PLAN N.T.S.**