City of Prince George
HISTORY SHEET

614004208

SHEET NUMBER № 4885 **Roll Number**

Legal: LOT'S B-1-2-3-4 BLOCK 29 D.L. 937 PLAN 752

Address: 663 DOUGLAS STREET 707 DOUGLAS ST

Sanitary Connection: # 4240 SIZE 4" MATERIAL A.C.S. INV. CONNECTED

Water Connection # 1018 SIZE 3/4" MATERIAL METER CONNECTED

Storm Connection: # SIZE MATERIAL INV. CONNECTED

Cash Receipt No's: WATER SANITARY 2224 STORM

CURB FROM PROPERTY LINE PAVEMENT WIDTH

B.C. HYDRO UNDERGROUND CONNECTION

B.C. TELEPHONE UNDERGROUND CONNECTION

INLAND GAS

Information Sheets:

Comments: THE INFORMATION CONTAINED HEREIN IS FOR INTERNAL USE ONLY. NOT TO BE RELIED UPON UNLESS CONFIRMED BY SITE INSPECTION AND/OR INVESTIGATION.
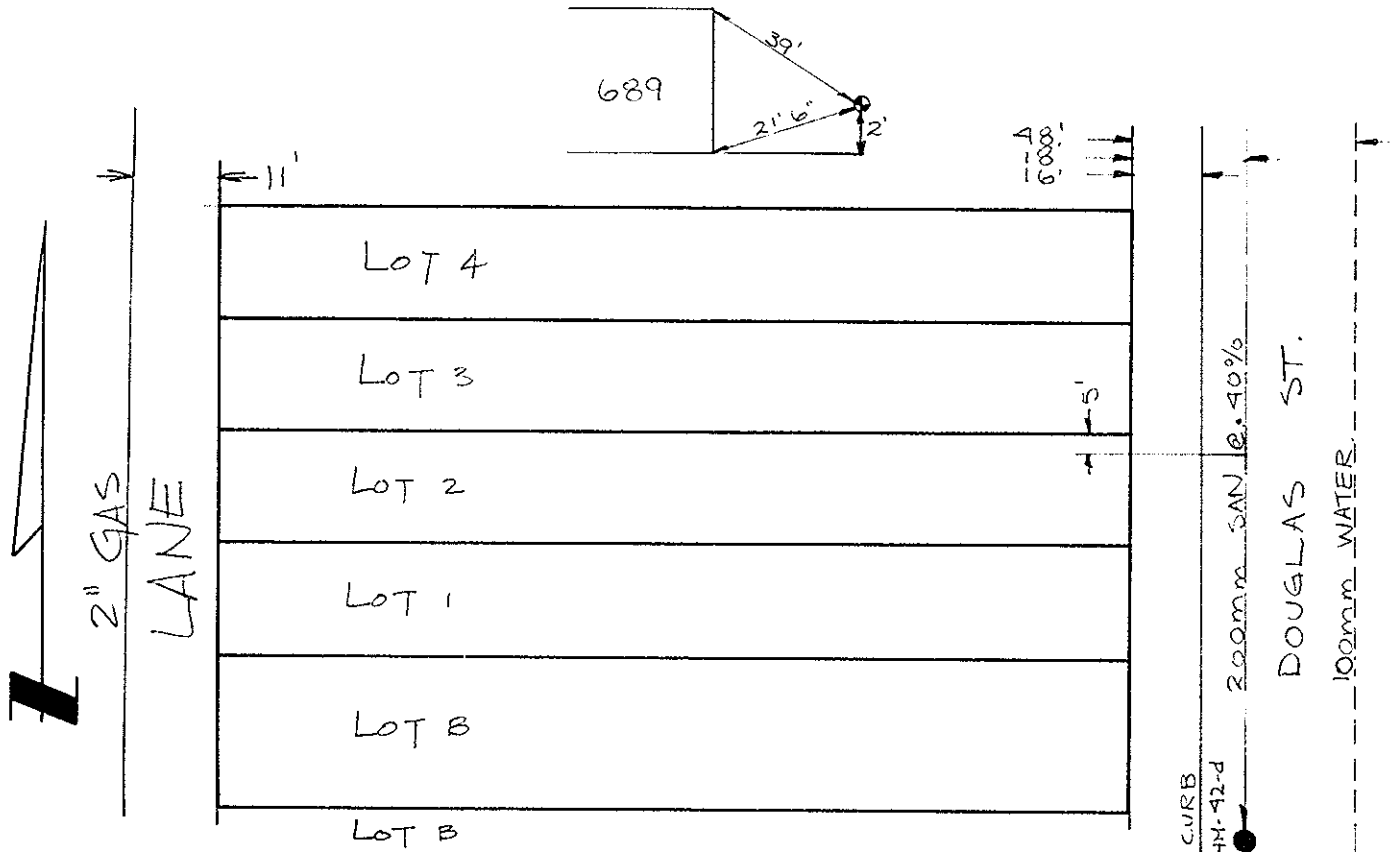
SITE PLAN N.T.S.