014024301
014024845

City of Prince George
HISTORY SHEET

SHEET NUMBER **Roll Number** 014024888

Legal: LOT'S 21, 22, N½ 23 BLOCK 1 D.L. 2610 PLAN 847

Address: 138 Ruggles St.

Sanitary Connection: # SIZE MATERIAL INV. CONNECTED

Water Connection # SIZE 20mm MATERIAL Cu METER CONNECTED

Storm Connection: # SIZE MATERIAL INV. CONNECTED

Cash Receipt No's: WATER SANITARY STORM

CURB FROM PROPERTY LINE PAVEMENT WIDTH

B.C. HYDRO UNDERGROUND CONNECTION

B.C. TELEPHONE UNDERGROUND CONNECTION

INLAND GAS

Information Sheets:

Comments:
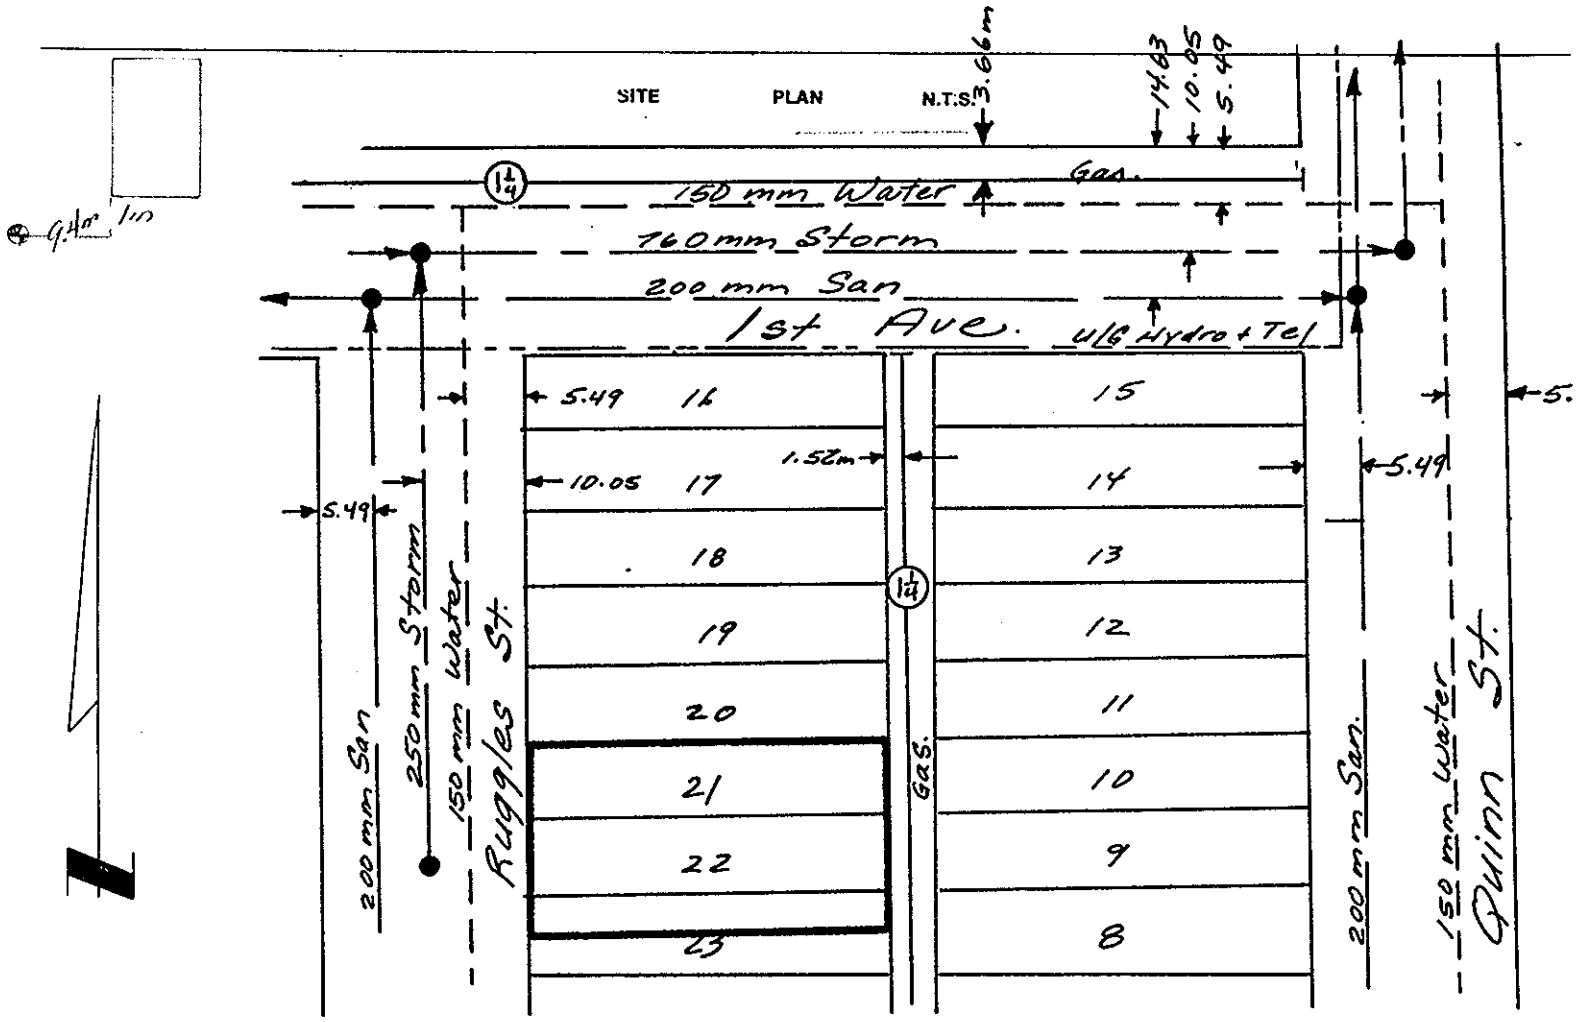
SITE PLAN N.T.S.