City of Prince George
HISTORY SHEET

014025278
014025272

SHEET NUMBER **Roll Number**

Legal: LOT'S N½ 13, 14, 15 BLOCK 8 D.L. 2610 PLAN 847

Address: 107 Ruggles St.

Sanitary Connection: # 4302 SIZE 100mm MATERIAL AC INV. CONNECTED

Water Connection # SIZE 20mm MATERIAL Cu METER CONNECTED

Storm Connection: # SIZE MATERIAL INV. CONNECTED

Cash Receipt No's: WATER SANITARY STORM

CURB FROM PROPERTY LINE PAVEMENT WIDTH

B.C. HYDRO UNDERGROUND CONNECTION

B.C. TELEPHONE UNDERGROUND CONNECTION

INLAND GAS

Information Sheets:
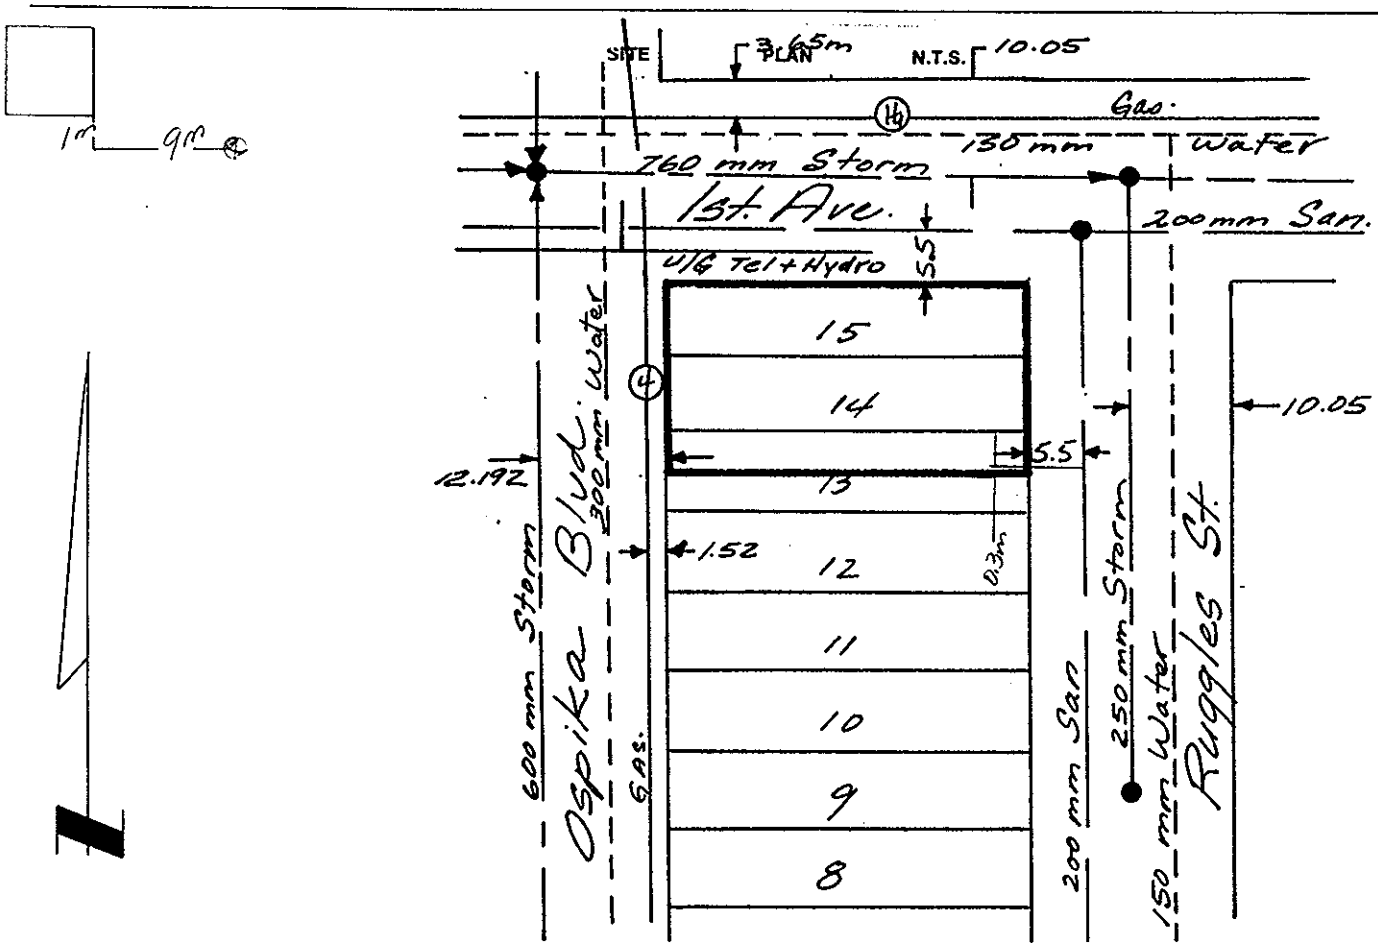
Comments: