021
048

City of Prince George
HISTORY SHEET

SHEET NUMBER **Roll Number**

Legal: LOT'S 27-29 BLOCK 10 D.L. 932 PLAN 796

Address: 2215 PINE STREET

Sanitary Connection: # 6663 SIZE 100 mm MATERIAL A.C. INV. 567.170 CONNECTED

Water Connection # 5000 SIZE 20 mm MATERIAL CU. METER CONNECTED

Storm Connection: # SIZE MATERIAL INV. CONNECTED

Cash Receipt No's: WATER SANITARY STORM

CURB FROM PROPERTY LINE 5.790 m PAVEMENT WIDTH 12.801 m

B.C. HYDRO O/H UNDERGROUND CONNECTION

B.C. TELEPHONE O/H UNDERGROUND CONNECTION

INLAND GAS 4.572 m FROM EAST SIDE OF PINE ST.

Information Sheets:

Comments:
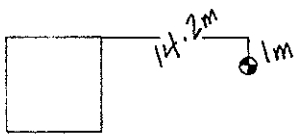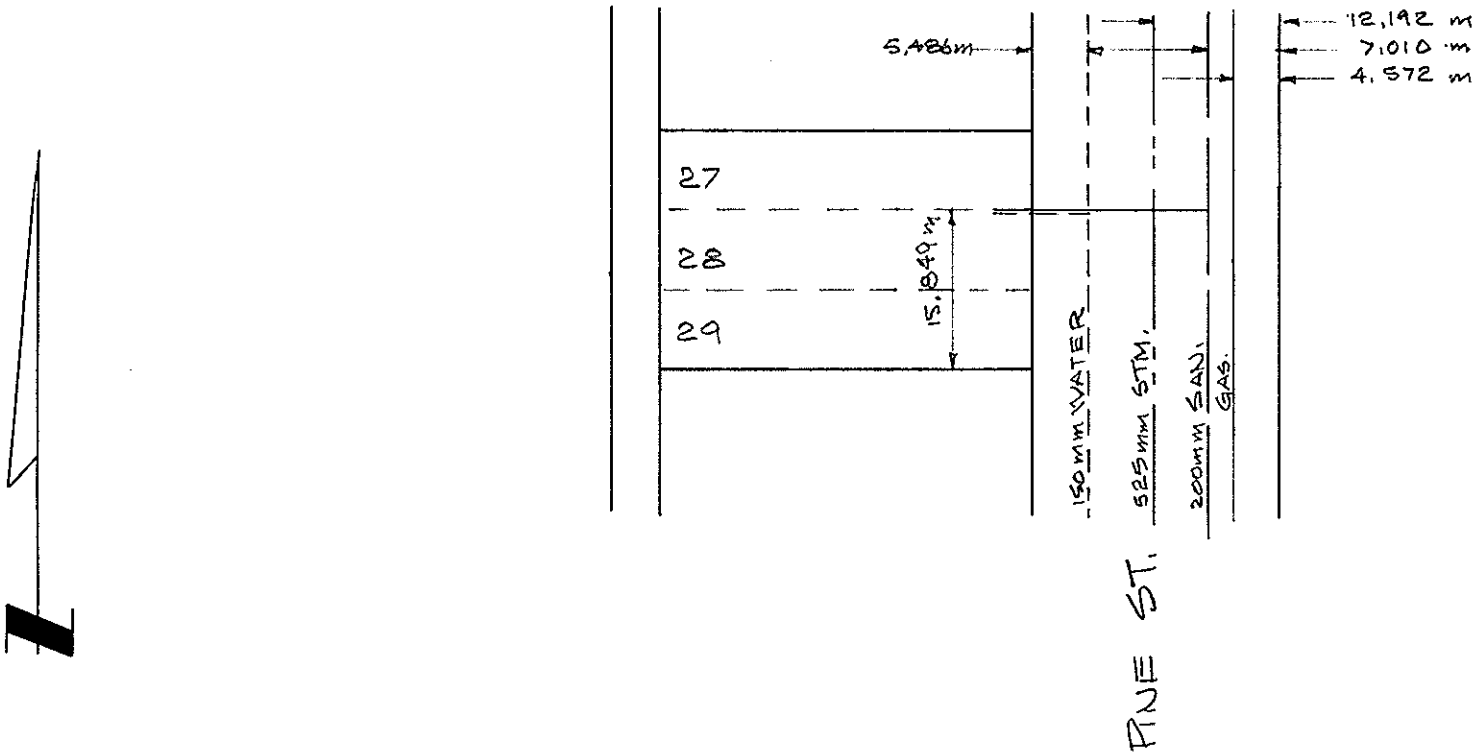
SITE PLAN N.T.S.