JH058344

City of Prince George
HISTORY SHEET

SHEET NUMBER | **Roll Number**

Legal: LOT'S PARCEL A (7-9) BLOCK 1 D.L. 932 PLAN 796

Address: 2120 PINE ST

Sanitary Connection: # 6720 SIZE 100mm MATERIAL AC. INV. CONNECTED

Water Connection # 6720 SIZE 12.7(½") MATERIAL Cu METER CONNECTED

Storm Connection: # SIZE MATERIAL INV. CONNECTED

Cash Receipt No's: WATER SANITARY 72 STORM

CURB FROM PROPERTY LINE PAVEMENT WIDTH

B.C. HYDRO UNDERGROUND CONNECTION

B.C. TELEPHONE UNDERGROUND CONNECTION

INLAND GAS

Information Sheets:

Comments:
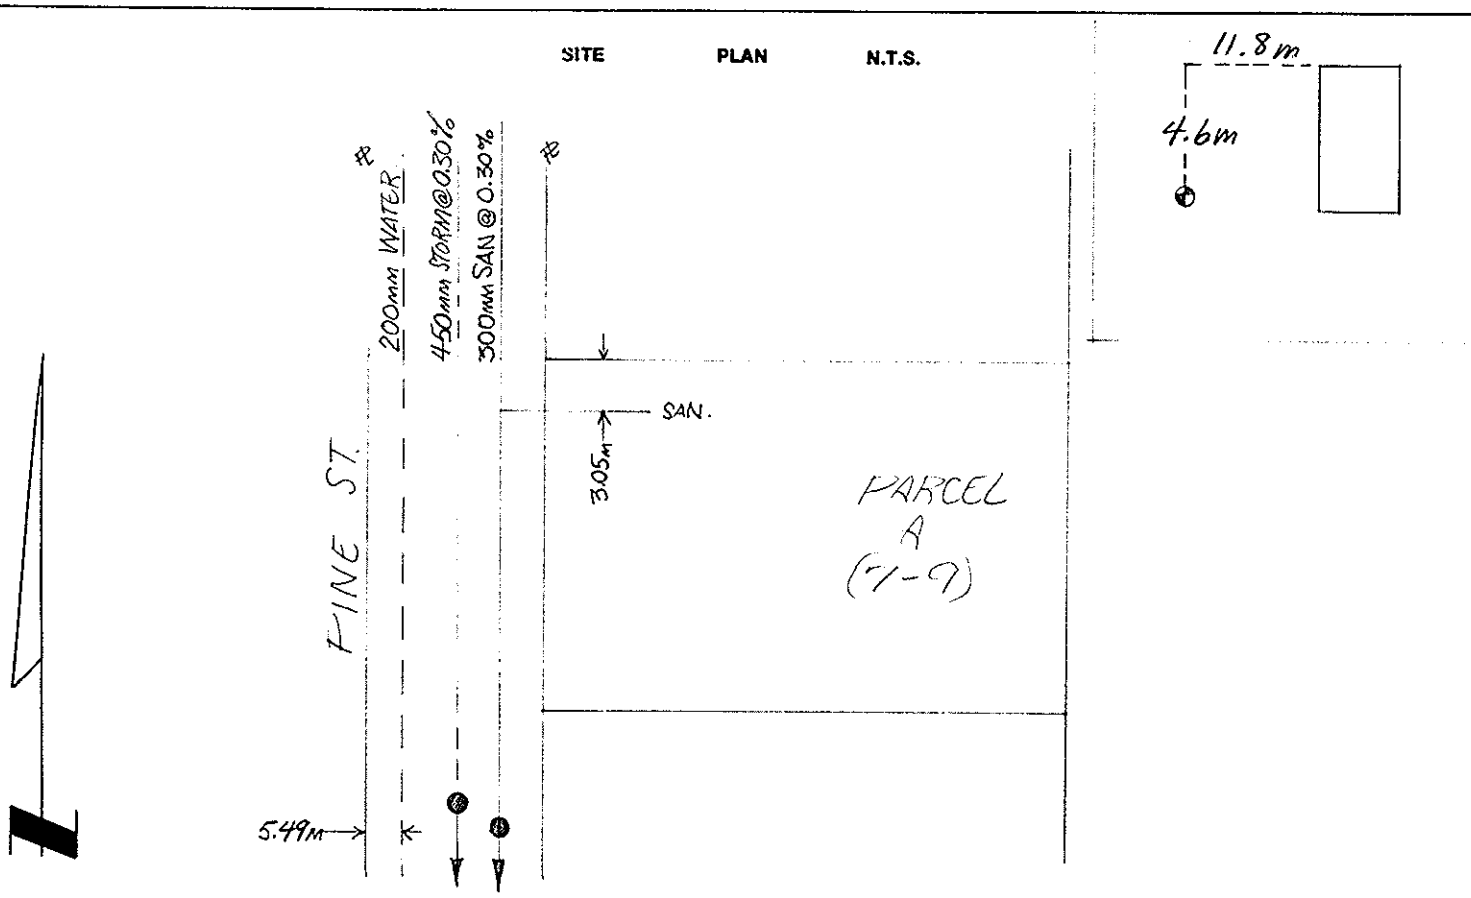
SITE PLAN N.T.S.