831

City of Prince George
HISTORY SHEET

SHEET NUMBER **Roll Number**

Legal: LOT'S 10 & 11 BLOCK 7 D.L. 932 PLAN 796

Address: 2134 PINE STREET

Sanitary Connection: # 6637 SIZE 100mm MATERIAL A.C. INV. 568.264 CONNECTED

Water Connection # 6637 SIZE 20mm MATERIAL CU. METER CONNECTED

Storm Connection: # SIZE MATERIAL INV. CONNECTED

Cash Receipt No's: WATER SANITARY 52 STORM

CURB FROM PROPERTY LINE 5.791 m PAVEMENT WIDTH 12.801 m

B.C. HYDRO O/H UNDERGROUND CONNECTION

B.C. TELEPHONE O/H UNDERGROUND CONNECTION

INLAND GAS 3.657m FROM PL

Information Sheets:

Comments: WITH THAW WIRE.

SITE PLAN N.T.S.

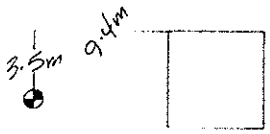

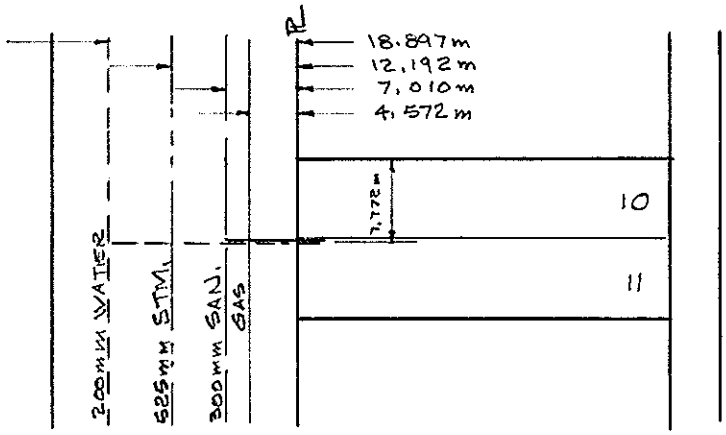

PINE ST.