City of Prince George
HISTORY SHEET

014031175

SHEET NUMBER | **Roll Number** 014081440

Legal: LOT'S S½ 18, 19 20 BLOCK 7 D.L. 2610 PLAN 847

Address: 122 Ruggles St.

Sanitary Connection: # 4300 SIZE 100mm MATERIAL AC INV. CONNECTED

Water Connection # SIZE 20mm MATERIAL Cu METER CONNECTED

Storm Connection: # SIZE MATERIAL INV. CONNECTED

Cash Receipt No's: WATER SANITARY STORM

CURB FROM PROPERTY LINE PAVEMENT WIDTH

B.C. HYDRO UNDERGROUND CONNECTION

B.C. TELEPHONE UNDERGROUND CONNECTION

INLAND GAS

Information Sheets:

Comments:
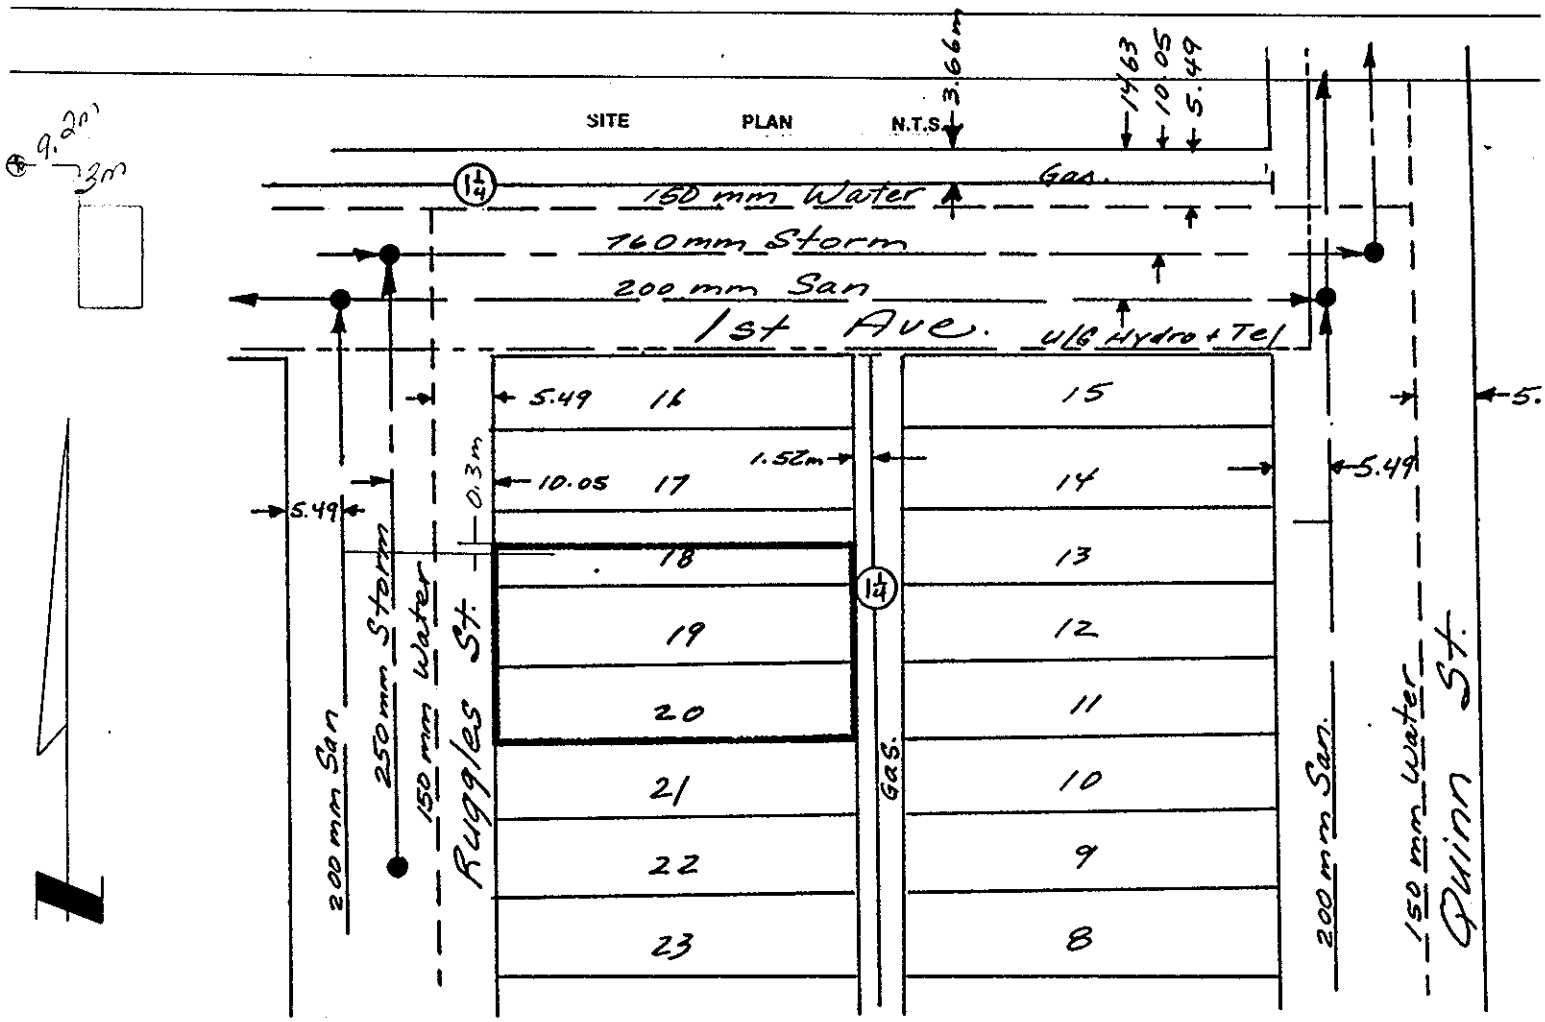
SITE PLAN N.T.S.