City of Prince George
HISTORY SHEET

014/01 947

SHEET NUMBER № 1489 **Roll Number** 955

Legal: LOT'S 1,2 BLOCK 63 D.L. 937 PLAN 752

Address: 385 EWERT STREET

Sanitary Connection: # 6728 SIZE 4" MATERIAL A.C. INV. CONNECTED

Water Connection # 1282 SIZE 3/4" MATERIAL COPPER METER CONNECTED

Storm Connection: # SIZE MATERIAL INV. CONNECTED

Cash Receipt No's: WATER SANITARY 225 STORM

CURB FROM PROPERTY LINE PAVEMENT WIDTH

B.C. HYDRO UNDERGROUND CONNECTION

B.C. TELEPHONE UNDERGROUND CONNECTION

INLAND GAS

Information Sheets:

Comments:
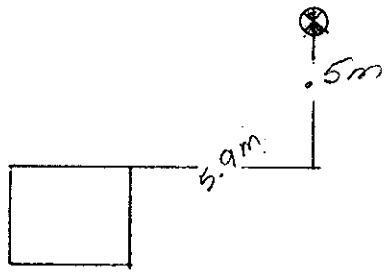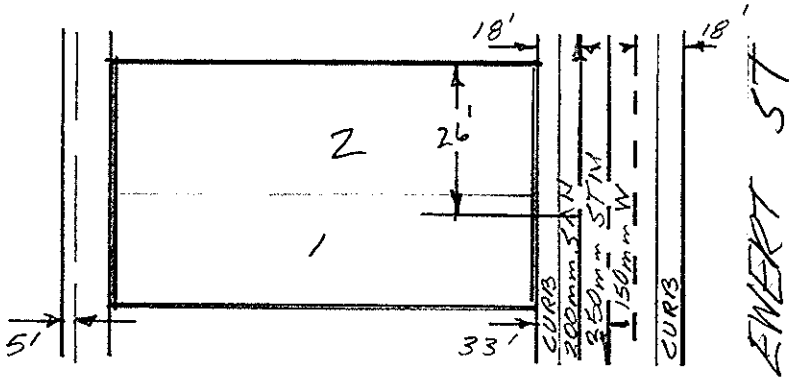
SITE PLAN N.T.S.