493
515

City of Prince George
HISTORY SHEET

SHEET NUMBER **Roll Number**

Legal: LOT'S 7-8-9 BLOCK 4 D.L. 932 PLAN 796

Address: 2030 OAK ST.

Sanitary Connection: # 7132 SIZE 100 mm MATERIAL A.C. INV. 574.842 CONNECTED ✓

Water Connection # 7147 SIZE 20 mm MATERIAL CU. METER CONNECTED ✓

Storm Connection: # SIZE MATERIAL INV. CONNECTED

Cash Receipt No's: WATER SANITARY STORM

CURB FROM PROPERTY LINE VARIES PAVEMENT WIDTH VARIES

B.C. HYDRO O/H UNDERGROUND CONNECTION

B.C. TELEPHONE O/H UNDERGROUND CONNECTION

INLAND GAS 3.048 m FROM PL.

Information Sheets:

Comments: WITH THAW WIRE.

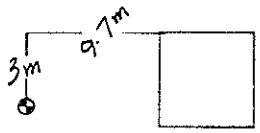

SITE PLAN N.T.S.

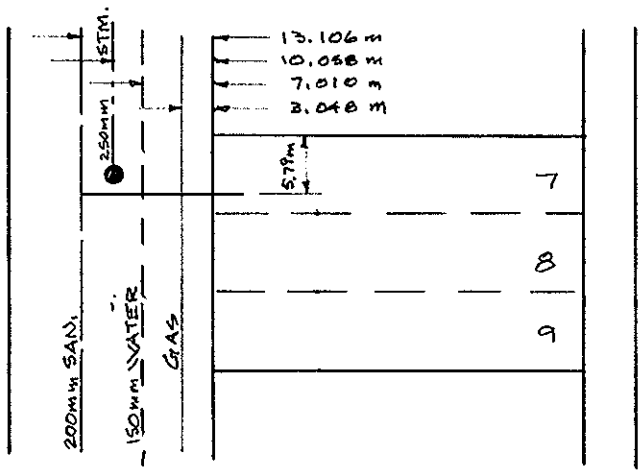

OAK ST.