City of Prince George
HISTORY SHEET

985
014140977

SHEET NUMBER № 4460 **Roll Number** 993

Legal: LOT'S 10-12 BLOCK 24 D.L. 1422 PLAN 646

Address: 1007 FREEMAN ST

Sanitary Connection: # 3035 SIZE MATERIAL INV. CONNECTED

Water Connection # 3212 SIZE 20mm MATERIAL COPPER METER CONNECTED

Storm Connection: # SIZE MATERIAL INV. CONNECTED

Cash Receipt No's: WATER SANITARY 576 STORM

CURB FROM PROPERTY LINE PAVEMENT WIDTH

B.C. HYDRO UNDERGROUND CONNECTION

B.C. TELEPHONE UNDERGROUND CONNECTION

INLAND GAS

Information Sheets:
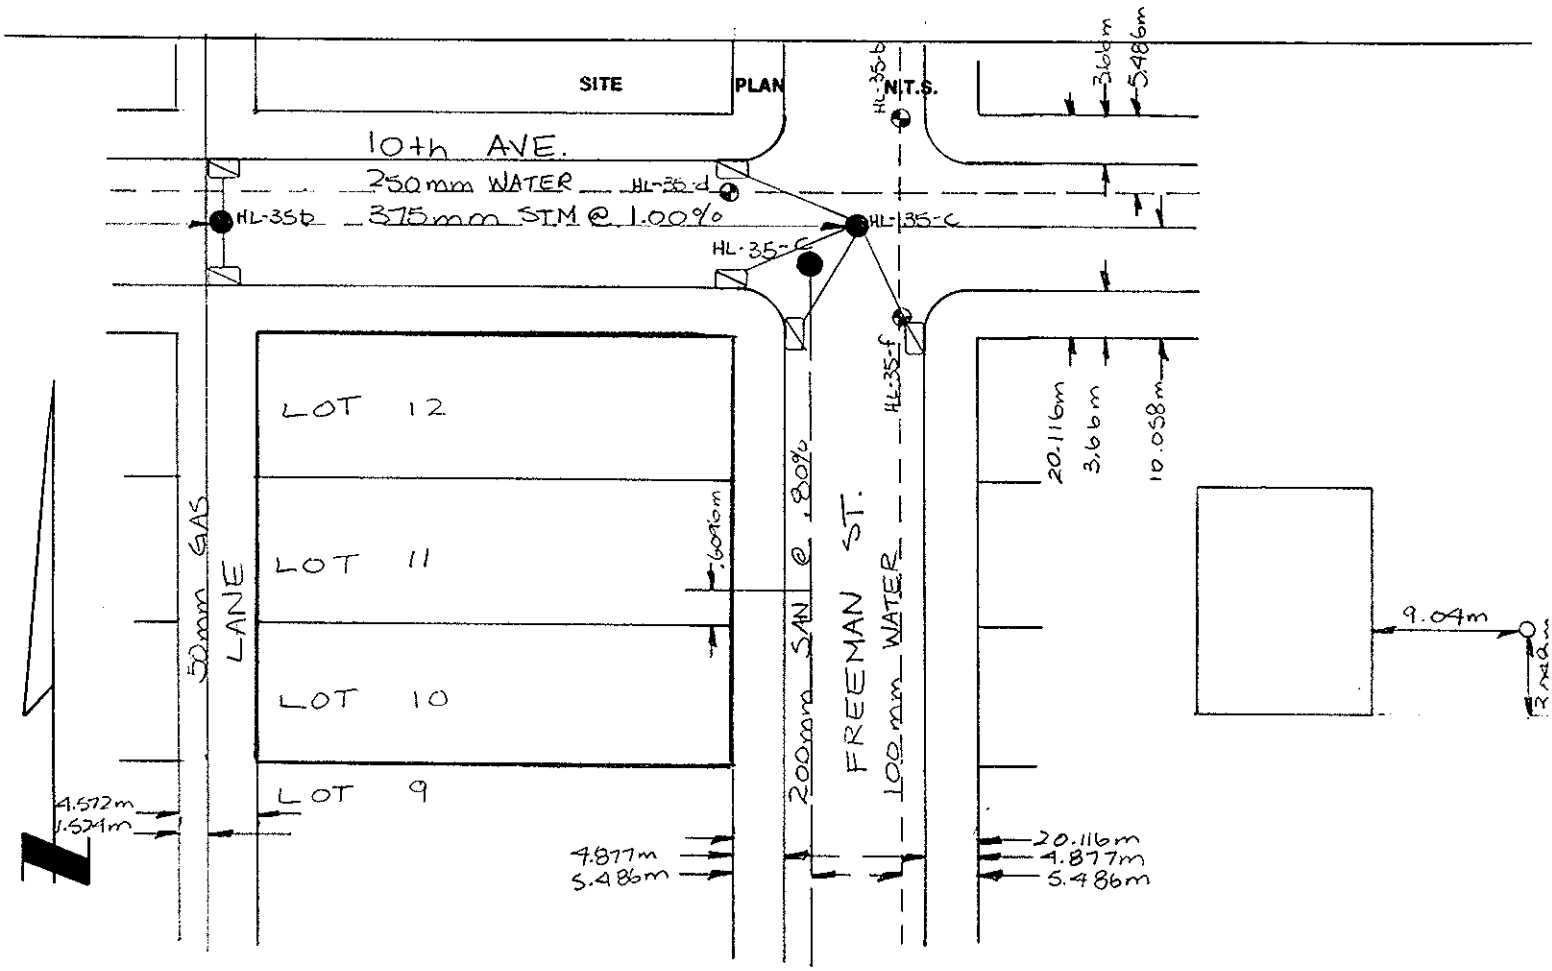
Comments: