141

City of Prince George
HISTORY SHEET

SHEET NUMBER № 1320 **Roll Number**

Legal: LOT'S 1, 2 BLOCK 51 D.L. 936 PLAN 696

Address: 993 JOHNSON STREET

Sanitary Connection: # 3258 SIZE MATERIAL INV. CONNECTED

Water Connection # 854 SIZE ½" MATERIAL COPPER METER CONNECTED

Storm Connection: # SIZE MATERIAL INV. CONNECTED

Cash Receipt No's: WATER SANITARY STORM

CURB FROM PROPERTY LINE PAVEMENT WIDTH

B.C. HYDRO UNDERGROUND CONNECTION

B.C. TELEPHONE UNDERGROUND CONNECTION

INLAND GAS

Information Sheets:

Comments:
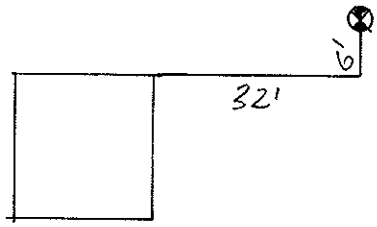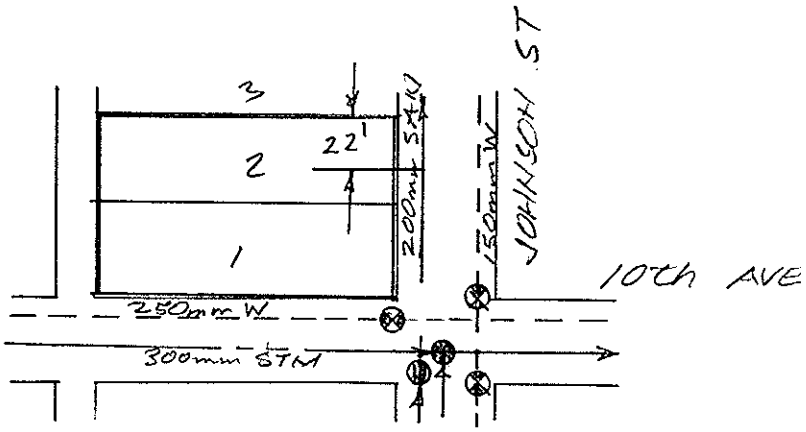
SITE PLAN N.T.S.