City of Prince George
HISTORY SHEET

SHEET NUMBER **Roll Number**

Legal: LOT'S 3 BLOCK 4 D.L. 934 PLAN 701

Address: 2419 NORWOOD STREET

Sanitary Connection: # 10153 SIZE 100mm MATERIAL AC INV. 066.317 CONNECTED

Water Connection # 10153 SIZE 20mm MATERIAL Cu. METER CONNECTED

Storm Connection: # SIZE MATERIAL INV. CONNECTED

Cash Receipt No's: WATER 834 SANITARY 832 STORM

CURB FROM PROPERTY LINE PAVEMENT WIDTH

B.C. HYDRO UNDERGROUND CONNECTION

B.C. TELEPHONE UNDERGROUND CONNECTION

INLAND GAS

Information Sheets:

Comments:

~~The information contained herein is for~~ internal use only. Not to be relied upon unless confirmed by site inspection and/or ~~investigation.~~
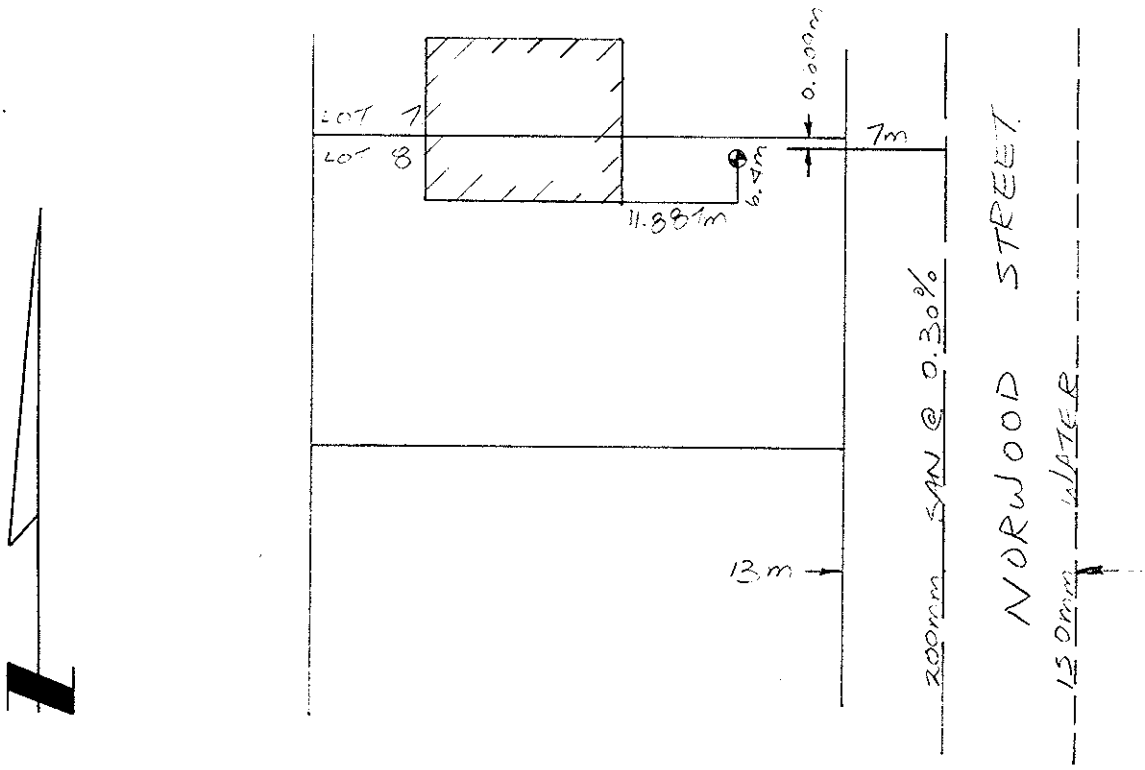
SITE PLAN N.T.S.