469

City of Prince George
HISTORY SHEET

1974 S.F. George Assessment Rol

SHEET NUMBER 8269 **Roll Number** 20 F 372.000

Legal: LOT'S 11 - 12 BLOCK 34 D.L. 933 PLAN 727

Address: 1129 Houston Lane

Sanitary Connection: # SIZE 4" MATERIAL AC INV. CONNECTED

Water Connection # SIZE 3/4" MATERIAL CU METER CONNECTED

Storm Connection: # SIZE MATERIAL INV. CONNECTED

Cash Receipt No's: WATER SANITARY STORM

CURB FROM PROPERTY LINE PAVEMENT WIDTH

B.C. HYDRO OH UNDERGROUND CONNECTION

B.C. TELEPHONE OH UNDERGROUND CONNECTION

INLAND GAS

Information Sheets:

Comments:

SITE PLAN N.T.S.

Sewer

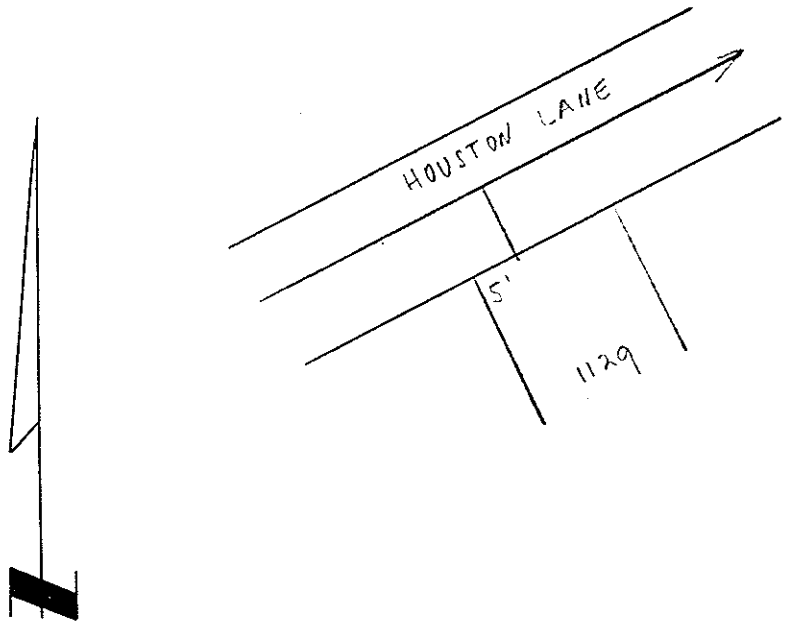
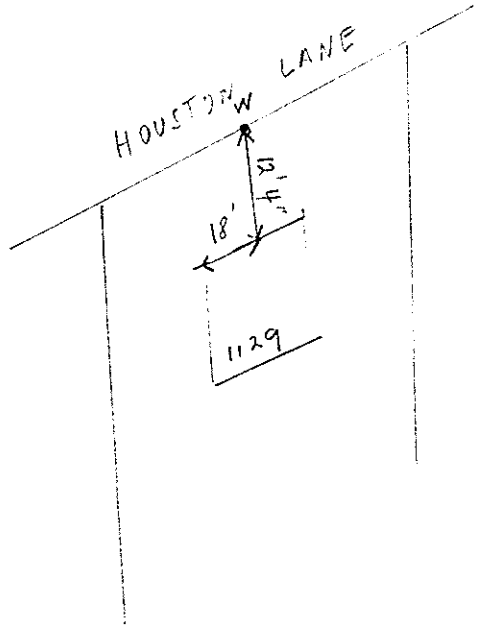
Water