City of Prince George
HISTORY SHEET

014144101
013482003

SHEET NUMBER № 4831 **Roll Number** 014144204

Legal: LOT'S 20 - 22 BLOCK 31 D.L. 937 PLAN 752

Address: 570 DOUGLAS STREET

Sanitary Connection: # 3962 SIZE MATERIAL INV. CONNECTED

Water Connection # 1041 SIZE MATERIAL METER CONNECTED

Storm Connection: # SIZE MATERIAL INV. CONNECTED

Cash Receipt No's: WATER SANITARY STORM

CURB FROM PROPERTY LINE 16 PAVEMENT WIDTH 34

B.C. HYDRO UNDERGROUND CONNECTION

B.C. TELEPHONE UNDERGROUND CONNECTION

INLAND GAS

Information Sheets:

Comments:
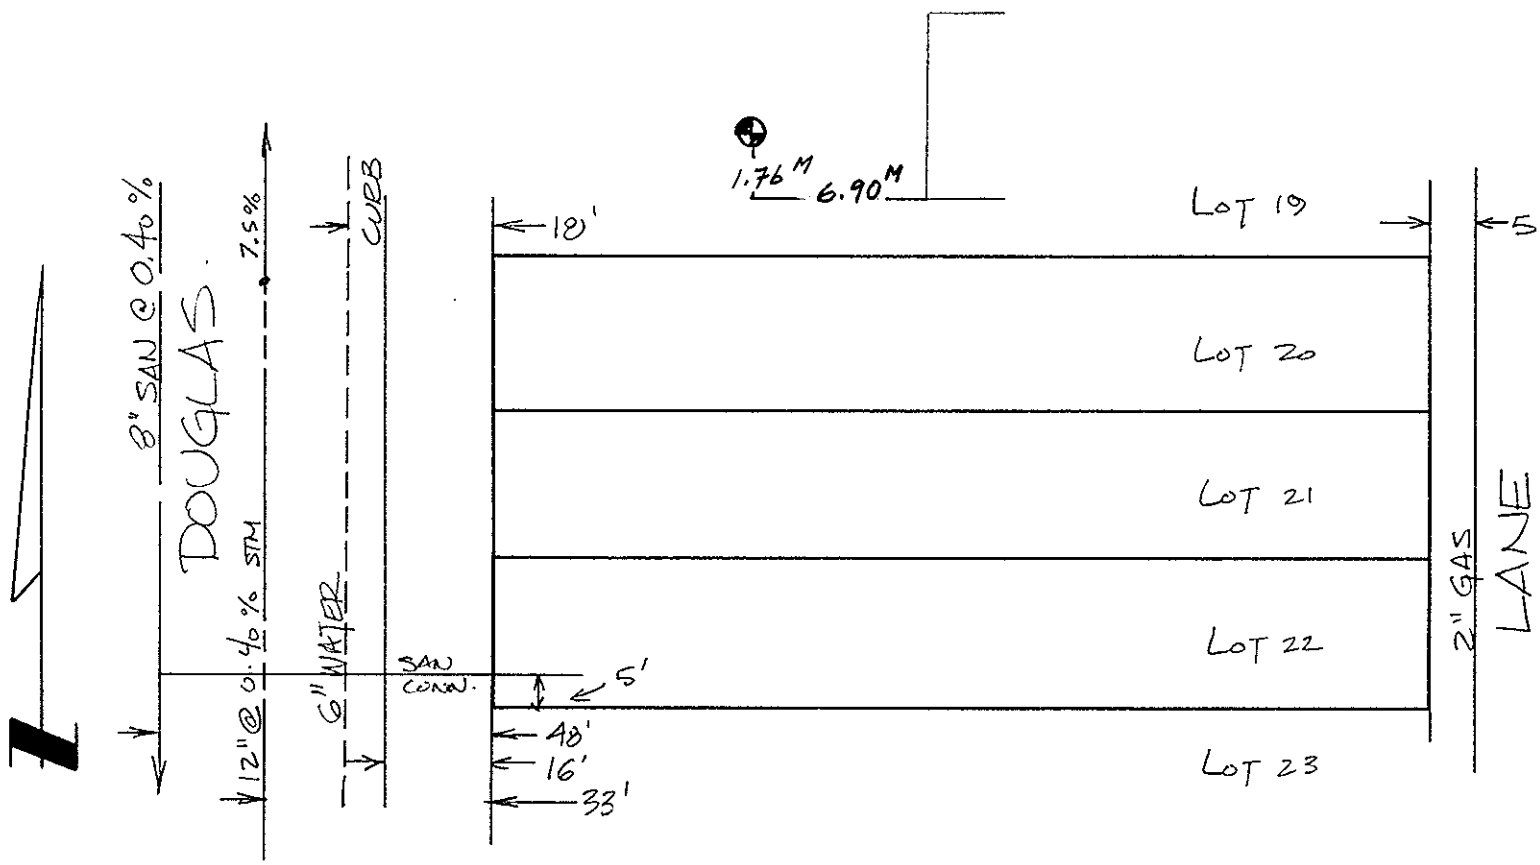
SITE PLAN N.T.S.