City of Prince George
HISTORY SHEET

347

SHEET NUMBER **Roll Number**

Legal: LOT'S 13 & 14 BLOCK 15 D.L. 932 PLAN 796

Address: 2316 PINE STREET

Sanitary Connection: # 6690 SIZE 100 mm MATERIAL A.C. INV. 565.405 CONNECTED

Water Connection # 6655 SIZE 20 mm MATERIAL C.W. METER CONNECTED

Storm Connection: # SIZE MATERIAL INV. CONNECTED

Cash Receipt No's: WATER SANITARY STORM

CURB FROM PROPERTY LINE 5.790 m PAVEMENT WIDTH 12.801 m

B.C. HYDRO O/H UNDERGROUND CONNECTION

B.C. TELEPHONE O/H UNDERGROUND CONNECTION

INLAND GAS 4.572 m FROM ℞.

Information Sheets:

Comments:
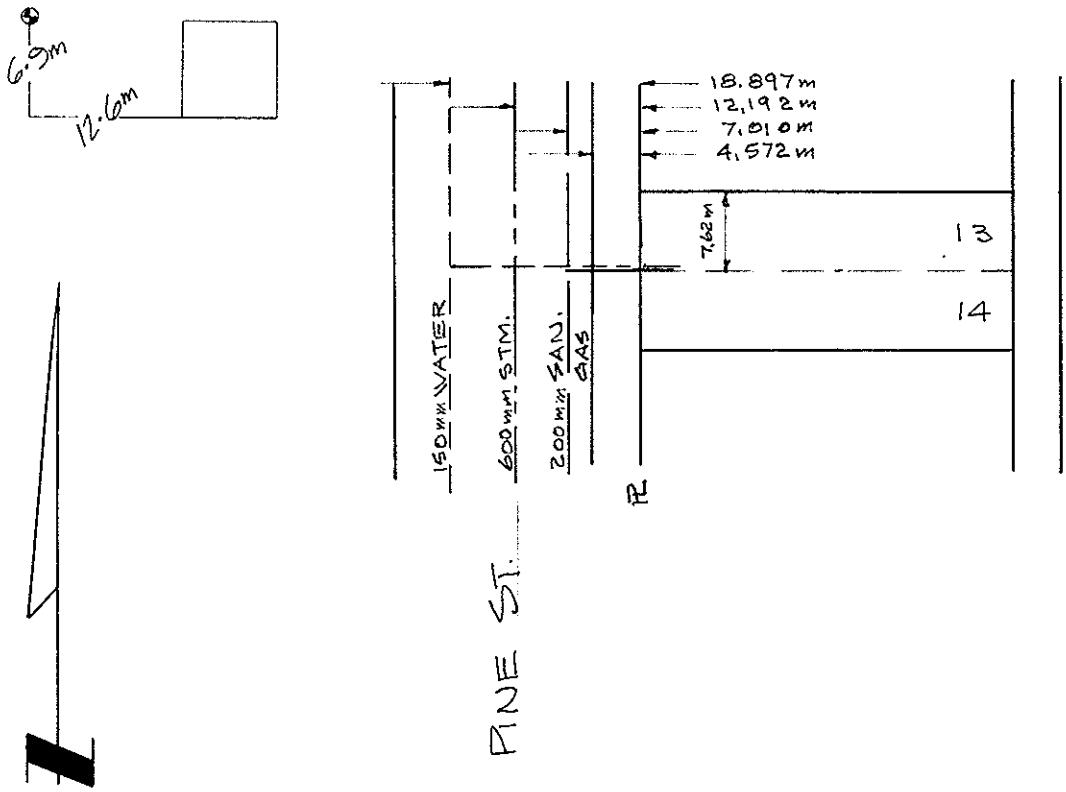
SITE PLAN N.T.S.