665

City of Prince George
HISTORY SHEET

1974 SFD

SHEET NUMBER 8179 **Roll Number** 268

Legal: LOT'S 5 + 6 BLOCK 16 D.L. 933 PLAN 727

Address: 2637 ~~8th Street~~ 2639 MOYIE

Sanitary Connection: # SIZE 4" MATERIAL AC INV. CONNECTED 1971

Water Connection # SIZE 3/4" MATERIAL CU METER CONNECTED yes

Storm Connection: # SIZE MATERIAL INV. CONNECTED

Cash Receipt No's: WATER pd SANITARY pd STORM

CURB FROM PROPERTY LINE PAVEMENT WIDTH

B.C. HYDRO OH UNDERGROUND CONNECTION

B.C. TELEPHONE OH UNDERGROUND CONNECTION

INLAND GAS

Information Sheets:

Comments:

The information contained herein is for internal use only. Not to be relied upon unless confirmed by site inspection and/or investigation.
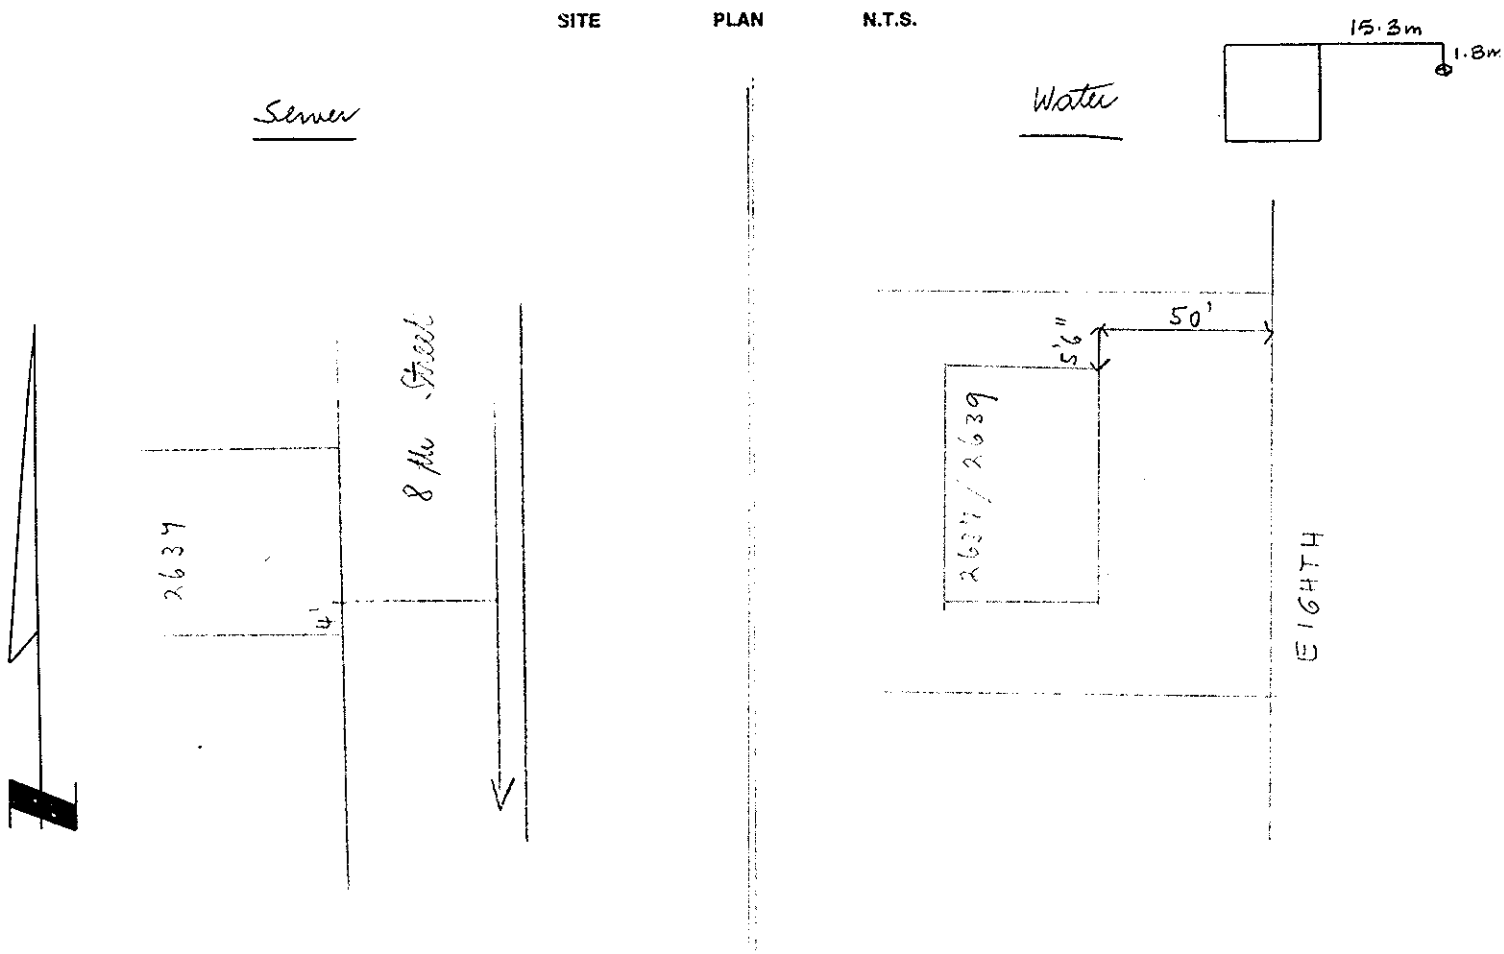
SITE PLAN N.T.S.