City of Prince George
HISTORY SHEET

JJ

SHEET NUMBER **Roll Number** 01462341

Legal: LOT'S 3 BLOCK 12 D.L. 1426 PLAN 721

Address: 2816 OAK ST.

Sanitary Connection: # 7159 SIZE 100 MM MATERIAL INV. CONNECTED

Water Connection # 7168 SIZE 20 MM MATERIAL CU METER CONNECTED

Storm Connection: # SIZE MATERIAL INV. CONNECTED

Cash Receipt No's: WATER 383 SANITARY 382 STORM

CURB FROM PROPERTY LINE PAVEMENT WIDTH

B.C. HYDRO UNDERGROUND CONNECTION

B.C. TELEPHONE UNDERGROUND CONNECTION

INLAND GAS

Information Sheets:

Comments:

THE INFORMATION CONTAINED HEREIN IS FOR INTERNAL USE ONLY. NOT TO BE RELIED UPON UNLESS CONFIRMED BY SITE INSPECTION AND/OR INVESTIGATION.
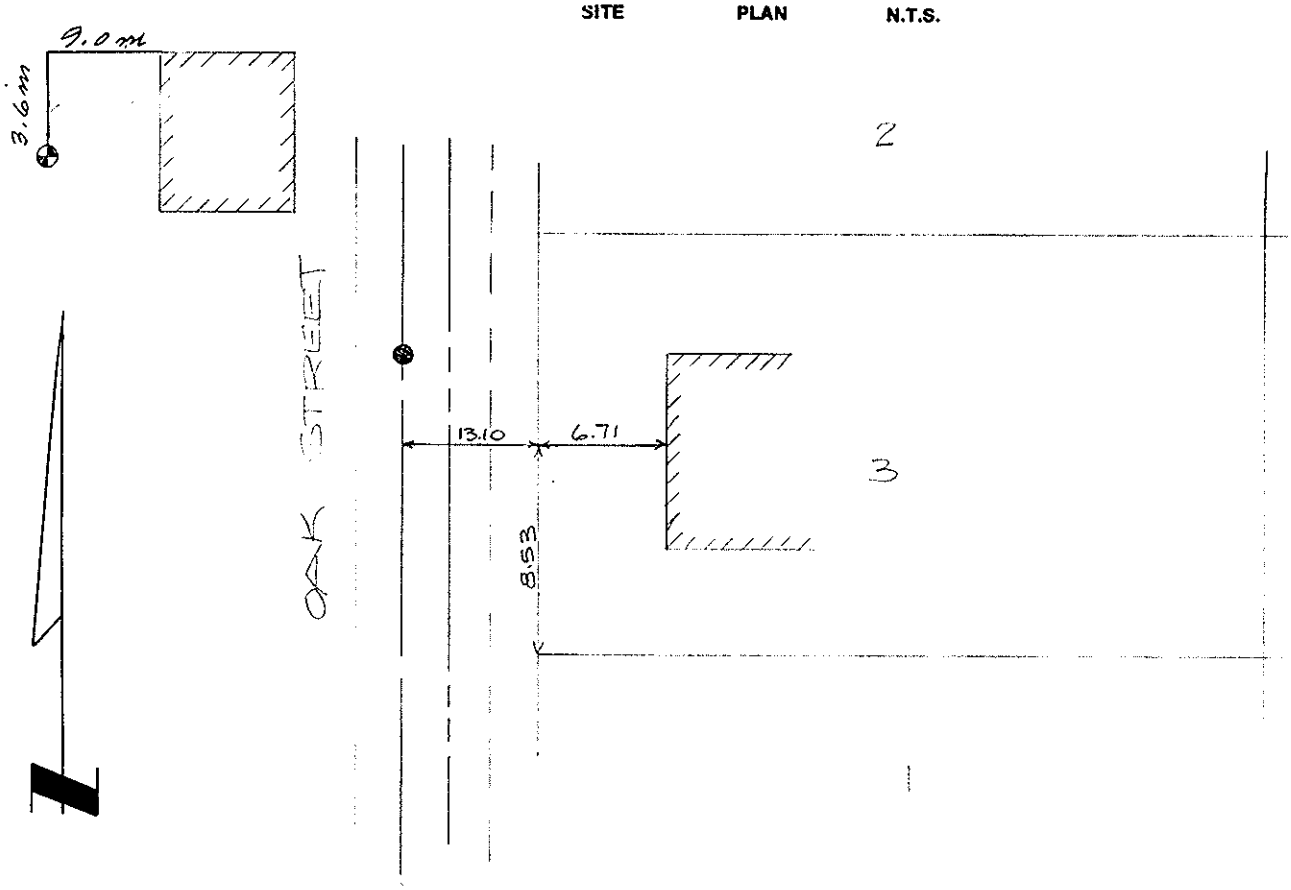
SITE PLAN N.T.S.