332

City of Prince George
HISTORY SHEET

1974 SFG

SHEET NUMBER 8189 **Roll Number** 273

Legal: LOT'S 6 - 7 BLOCK 17 D.L. 933 PLAN 727

Address: 2639 ~~7th Street~~ LILLOOET ST

Sanitary Connection: # SIZE 4" MATERIAL AC INV. CONNECTED 1971

Water Connection # SIZE 3/4" MATERIAL CU METER CONNECTED yes

Storm Connection: # SIZE MATERIAL INV. CONNECTED

Cash Receipt No's: WATER pd. SANITARY pd. STORM

CURB FROM PROPERTY LINE PAVEMENT WIDTH

B.C. HYDRO OH UNDERGROUND CONNECTION

B.C. TELEPHONE OH UNDERGROUND CONNECTION

INLAND GAS

Information Sheets:

Comments:
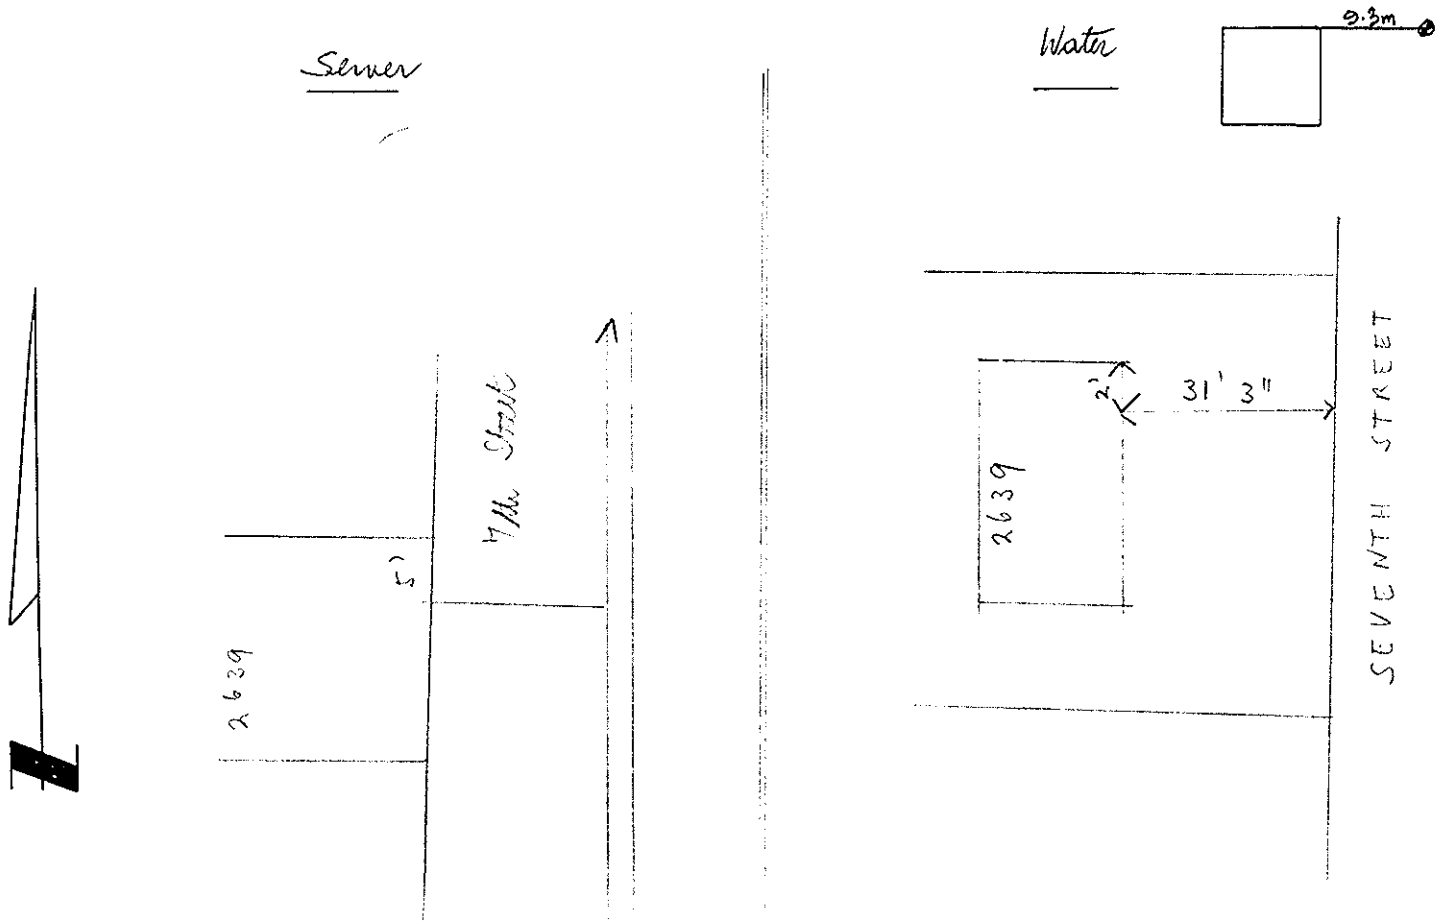
SITE PLAN N.T.S.