City of Prince George
HISTORY SHEET

349
357
1974 SFG Assessment

SHEET NUMBER 8095 **Roll Number** 183

Legal: LOT'S 5-6-7 BLOCK 5 D.L. 933 PLAN 727

Address: 2559 South Queensway

Sanitary Connection: # SIZE 4" MATERIAL AC INV. CONNECTED 1971

Water Connection # SIZE 3/4" MATERIAL CU METER CONNECTED 1956

Storm Connection: # 1030 SIZE 8" MATERIAL A.C. INV. CONNECTED

Cash Receipt No's: WATER pd. SANITARY pd. STORM LOTS 5-8 0885 (Compulsory)

CURB FROM PROPERTY LINE PAVEMENT WIDTH

B.C. HYDRO UNDERGROUND CONNECTION

B.C. TELEPHONE OH UNDERGROUND CONNECTION

INLAND GAS OH

Information Sheets:

Comments:
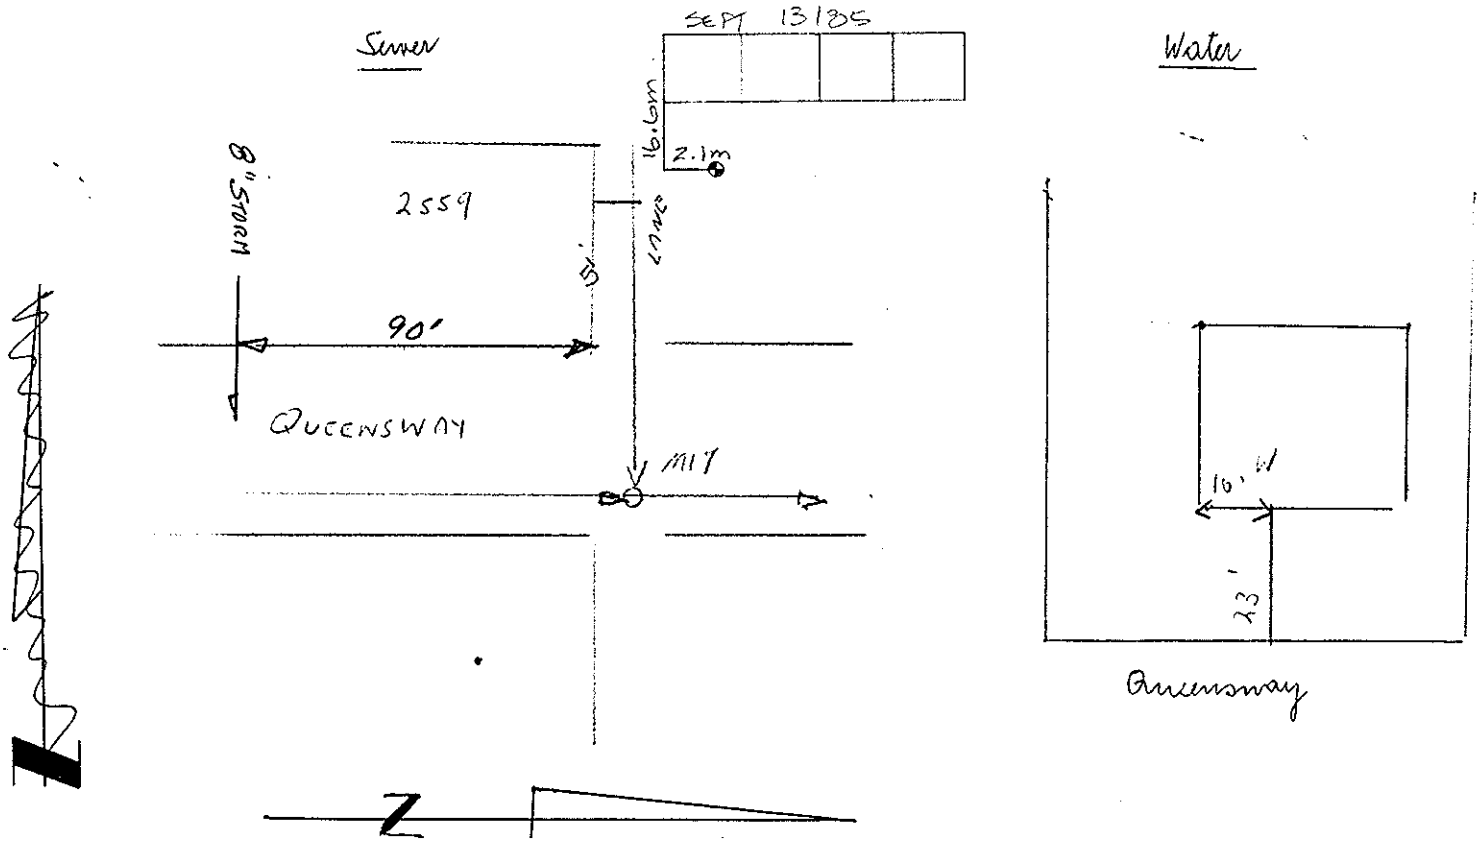
SITE PLAN N.T.S.