City of Prince George
HISTORY SHEET

1974 SFG ASSESSMENT

SHEET NUMBER **8304** **Roll Number** 411

Legal: LOT'S 15 - 16 BLOCK 12 D.L. 934 PLAN 701

Address: 798 ~~788~~ HAMILTON AVE

Sanitary Connection: # ~~NH~~ 11421 SIZE 4" MATERIAL A.C. INV. CONNECTED

Water Connection # SIZE 3/4" MATERIAL AC METER CONNECTED

Storm Connection: # SIZE MATERIAL INV. CONNECTED

Cash Receipt No's: WATER SANITARY 1980 STORM

CURB FROM PROPERTY LINE PAVEMENT WIDTH

B.C. HYDRO OH UNDERGROUND CONNECTION

B.C. TELEPHONE OH UNDERGROUND CONNECTION

INLAND GAS

Information Sheets:

Comments: Sewer not connected; WYE 1[illegible]

The information contained herein is for internal use only. Not to be relied upon unless confirmed by site inspection and/or investigation.
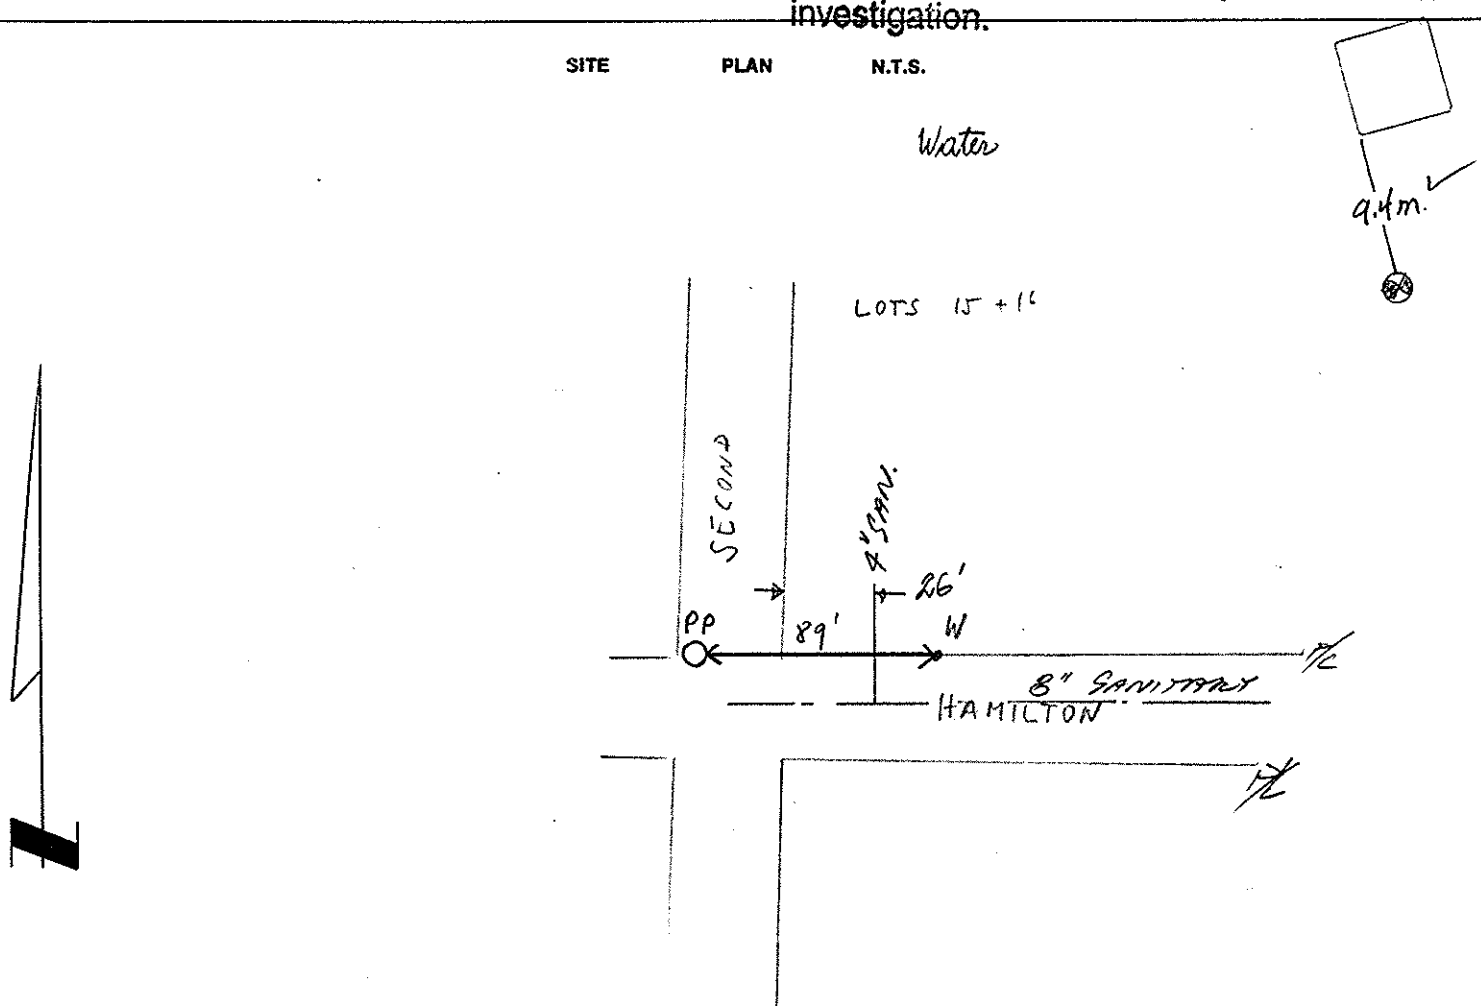
SITE PLAN N.T.S.