01310044 1
01310049 1
01310050 5
01310051 3
01597501 1

City of Prince George
HISTORY SHEET

SHEET NUMBER **2701** Roll Number

Legal: LOTS B, 1, 2, 4 PART OF 4 BLOCK 249 D.L. 343 PLAN 1268

Address: 1625 TAYLOR

Sanitary Connection: # 470 2.6054 SIZE MATERIAL INV. SEE COMMENTS CONNECTED

Water Connection # 2351 SIZE 1/2" Ø MATERIAL CG METER CONNECTED

Storm Connection: # SIZE MATERIAL INV. CONNECTED

Cash Receipt No's: WATER SANITARY STORM

CURB FROM PROPERTY LINE 16' PAVEMENT WIDTH 34'

B.C. HYDRO OH. UNDERGROUND CONNECTION

B.C. TELEPHONE OH UNDERGROUND CONNECTION

INLAND GAS AS SHOWN.

Information Sheets:
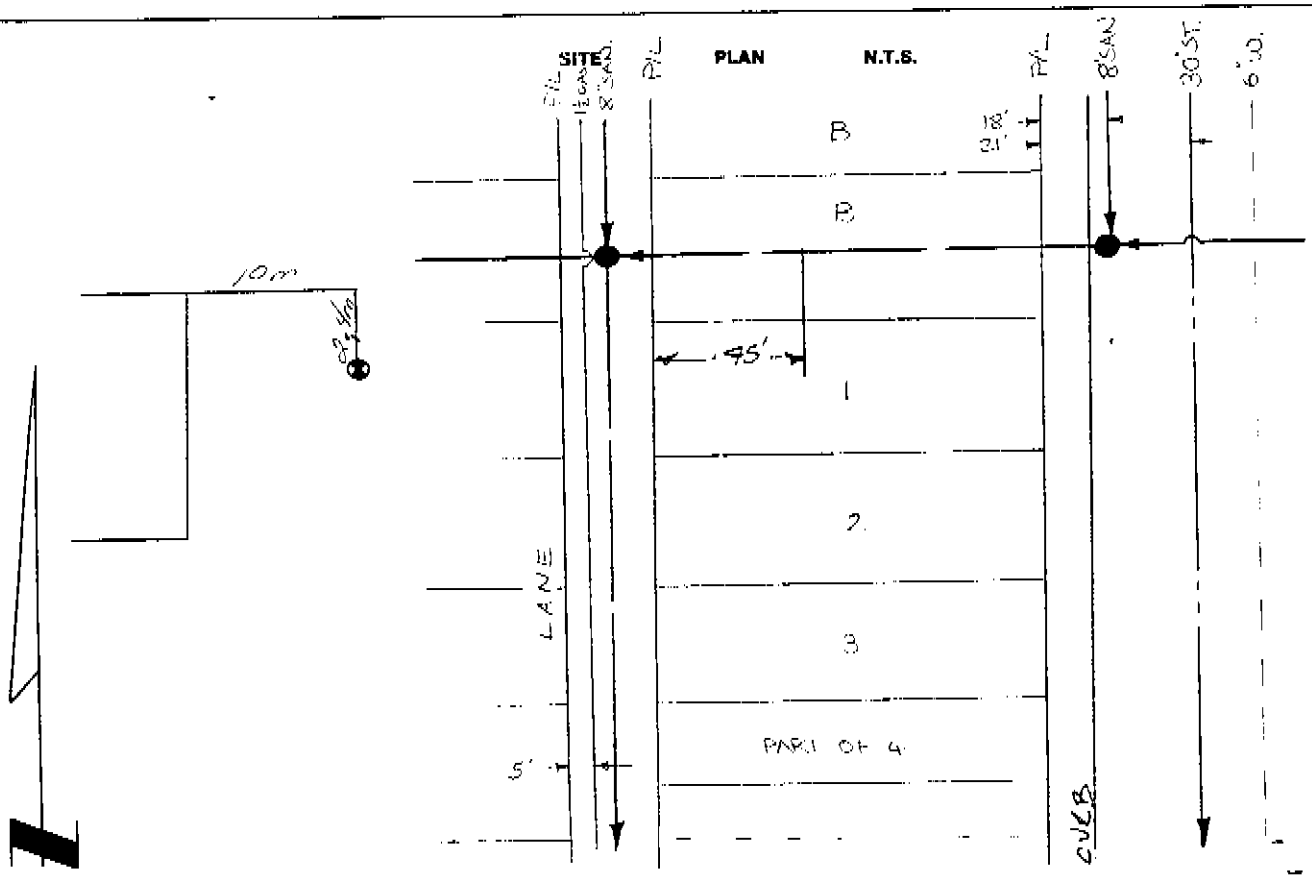
Comments: SAME 2' N OF P/L