015976122-
131-
149-
157-
165-
084-

City of Prince George
HISTORY SHEET

015976173- 015976238-
181- 246-
203- 254-
211- 262-
220- 271-
114- 092-
297-
106-

SHEET NUMBER **5307**

Roll Number

Legal: LOT'S 1-20 BLOCK 256 D.L. 343 PLAN 1268

Address: 1627 HEMLOCK ST.

Sanitary Connection: # - SIZE MATERIAL INV. CONNECTED

Water Connection # - SIZE CU MATERIAL METER CONNECTED

Storm Connection: # SIZE MATERIAL INV. CONNECTED

Cash Receipt No's: WATER SANITARY STORM

CURB FROM PROPERTY LINE PAVEMENT WIDTH

B.C. HYDRO O.H. UNDERGROUND CONNECTION

B.C. TELEPHONE O.H. UNDERGROUND CONNECTION

INLAND GAS AS SHOWN

Information Sheets:
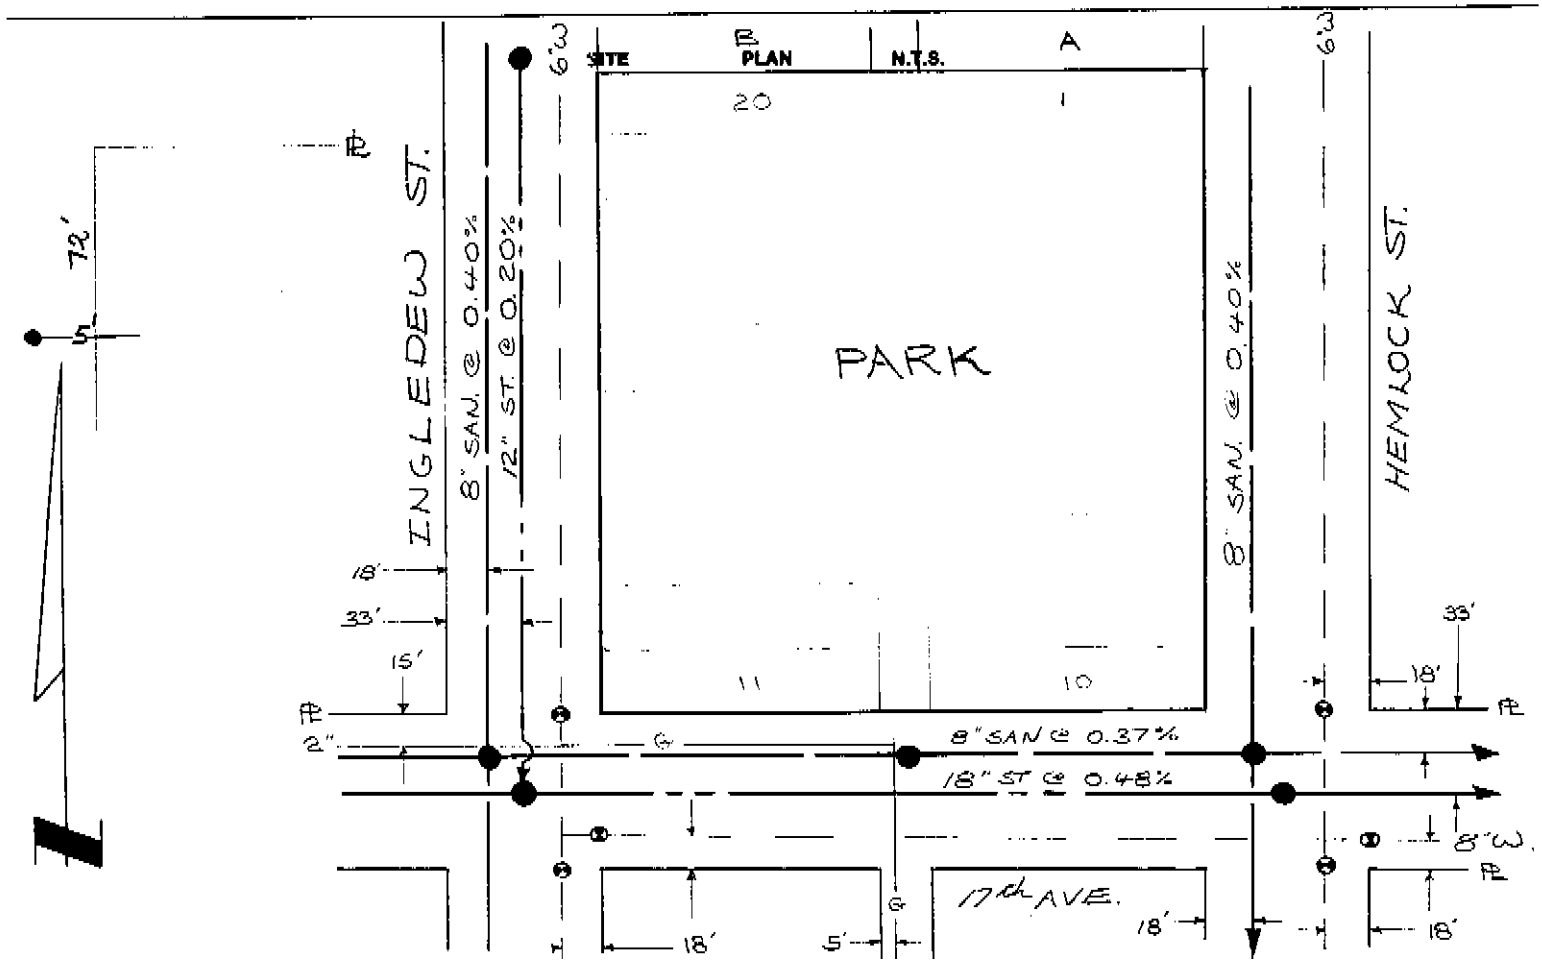
Comments: