City of Prince George
HISTORY SHEET

SHEET NUMBER **Roll Number** 017474582

Legal: LOT'S 7 BLOCK D.L. 482 PLAN 35622

Address: 4660 HUNTER PLACE

Sanitary Connection: # SIZE 100mm MATERIAL PVC INV. CONNECTED

Water Connection # SIZE 20mm MATERIAL CU METER CONNECTED

Storm Connection: # SIZE MATERIAL INV. CONNECTED

Cash Receipt No's: WATER SANITARY STORM

CURB FROM PROPERTY LINE PAVEMENT WIDTH

B.C. HYDRO UNDERGROUND CONNECTION

B.C. TELEPHONE UNDERGROUND CONNECTION

INLAND GAS

Information Sheets:

Comments:

THE INFORMATION CONTAINED HEREIN IS FOR INTERNAL USE ONLY.
NOT TO BE RELIED UPON UNLESS CONFIRMED BY SITE INSPECTION AND/OR INVESTIGATION

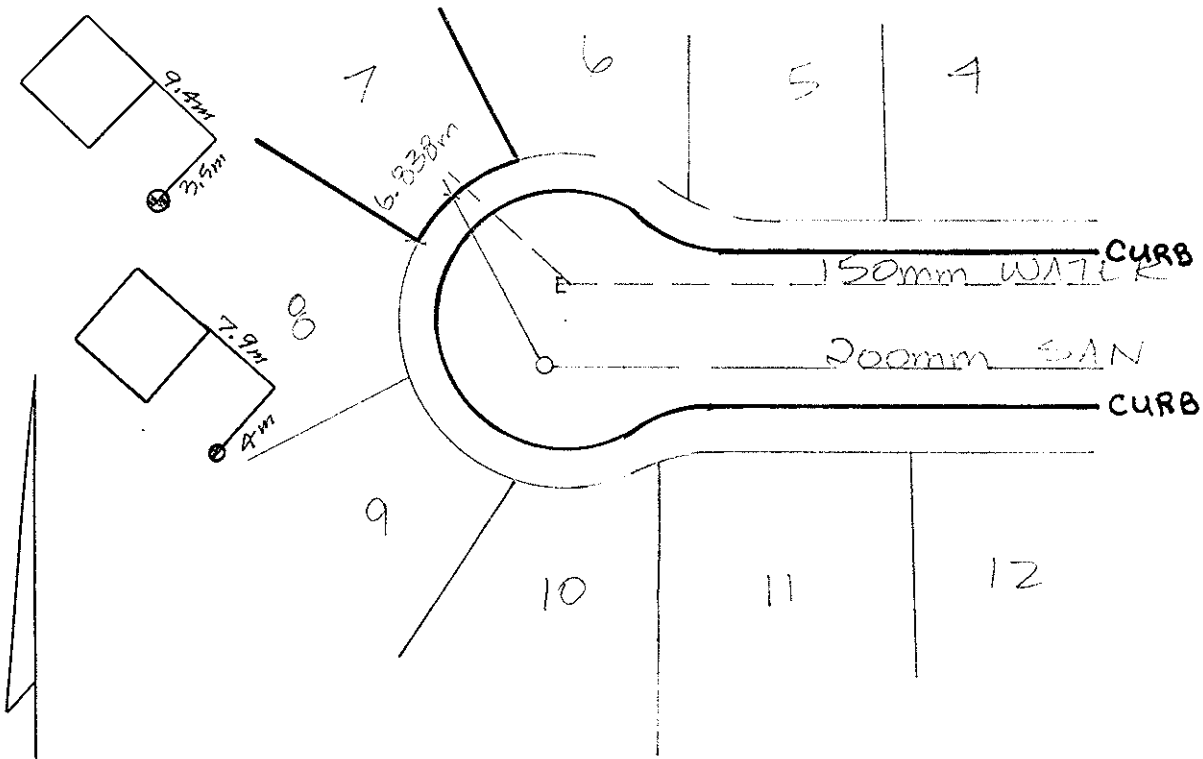

CONNECTIONS COMMON TRENCHED
℄ OF LOT