ASSOCIATED ENGINEERING SERVICES LTD.
301 - 1777 THIRD AVENUE
PRINCE GEORGE, B.C. V2L 3G7

City of Prince George
HISTORY SHEET

SHEET NUMBER № 3075 2408 PANORAMA PL. **Roll Number** 017-851.01

Legal: LOT'S 12 BLOCK D.L. 4045 PLAN 36414

Address: 2408 PANORAMA PLACE

Sanitary Connection: # SIZE 100mm MATERIAL P.V.C. INV. 731.57m CONNECTED

Water Connection # SIZE 19 mm MATERIAL COPPER METER CONNECTED

Storm Connection: # SIZE MATERIAL INV. CONNECTED

Cash Receipt No's: WATER SANITARY STORM

CURB FROM PROPERTY LINE 5.0m (ROLL CURB) PAVEMENT WIDTH 10.0m

B.C. HYDRO U/G UNDERGROUND CONNECTION

B.C. TELEPHONE U/G UNDERGROUND CONNECTION

INLAND GAS AS SHOWN

Information Sheets:

Comments: A.E.S.L. BENCH MARK : TOP F.H. SPIN. @ N/E COR. RIDGEVIEW
℄ N. LEG PANORAMA CRES. EL. 733.885 m
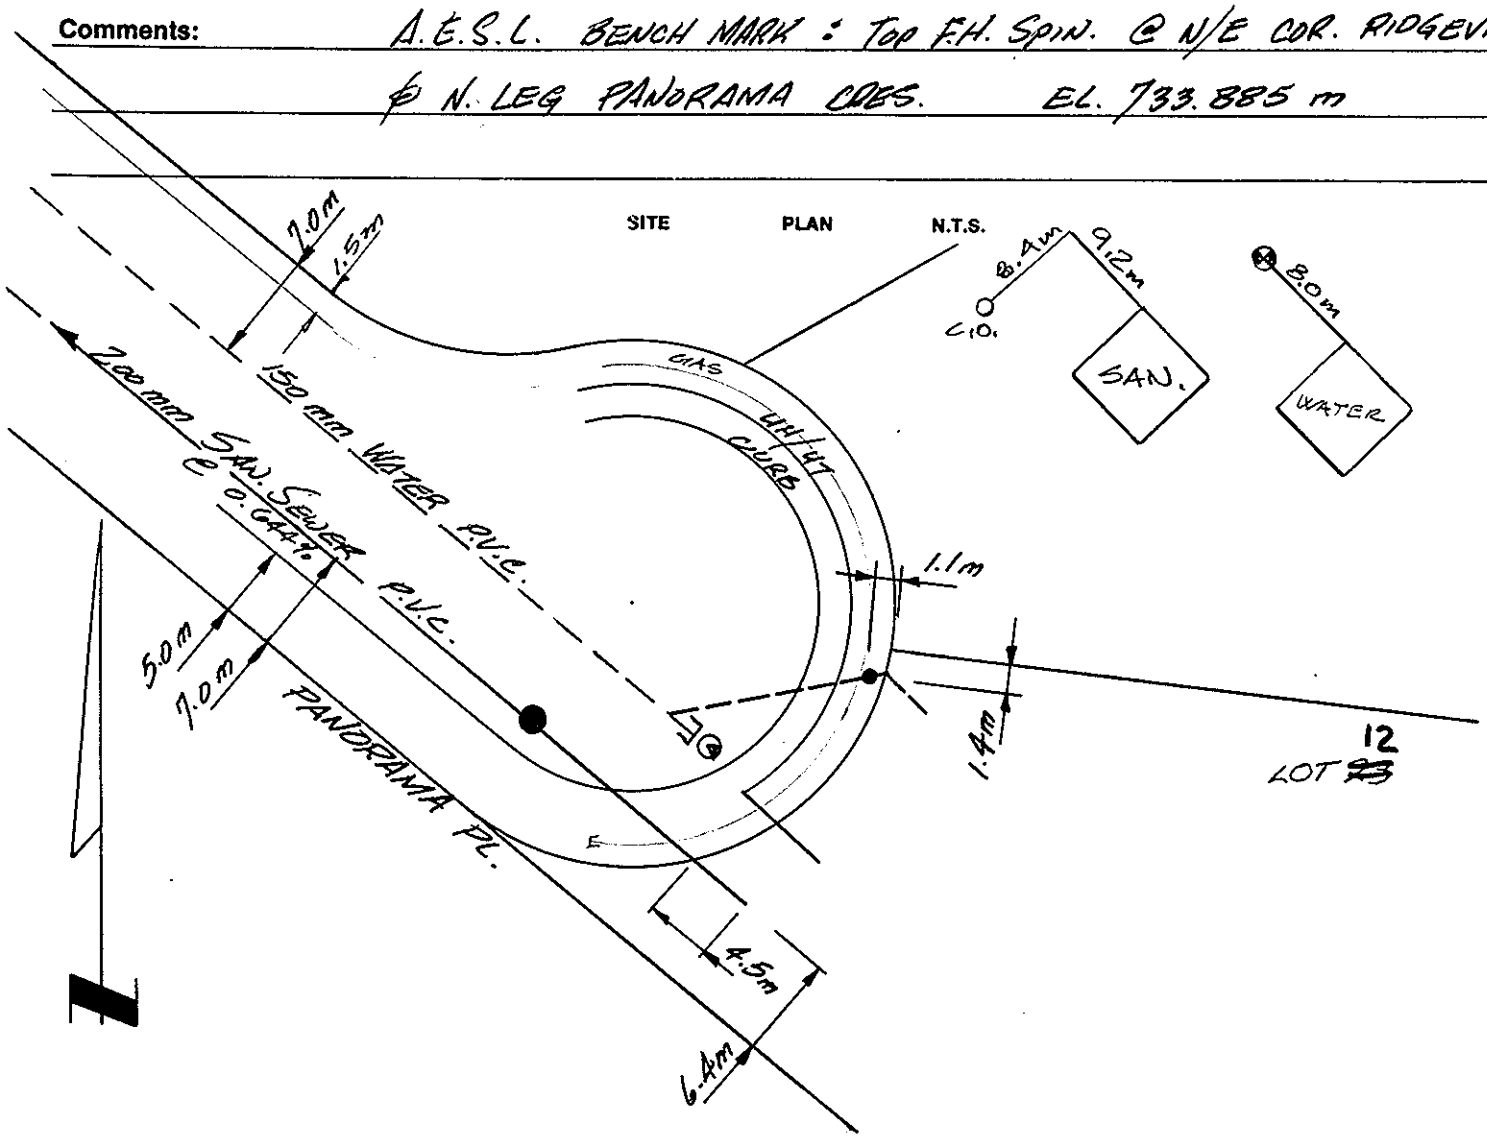
SITE PLAN N.T.S.