City of Prince George
HISTORY SHEET

317 987 423

SHEET NUMBER | **Roll Number**

Legal: LOT'S 1 BLOCK D.L. 4039 PLAN 36691

Address: 2849 MINNOTTI DRIVE

Sanitary Connection: # SIZE 100 mm MATERIAL AC INV. CONNECTED

Water Connection # SIZE 20 mm MATERIAL CU. METER CONNECTED

Storm Connection: # SIZE MATERIAL INV. CONNECTED

Cash Receipt No's: WATER 1102 SANITARY 1103 STORM

CURB FROM PROPERTY LINE | PAVEMENT WIDTH

B.C. HYDRO O/H UNDERGROUND CONNECTION

B.C. TELEPHONE O/H UNDERGROUND CONNECTION

INLAND GAS AS SHOWN

Information Sheets:

Comments:
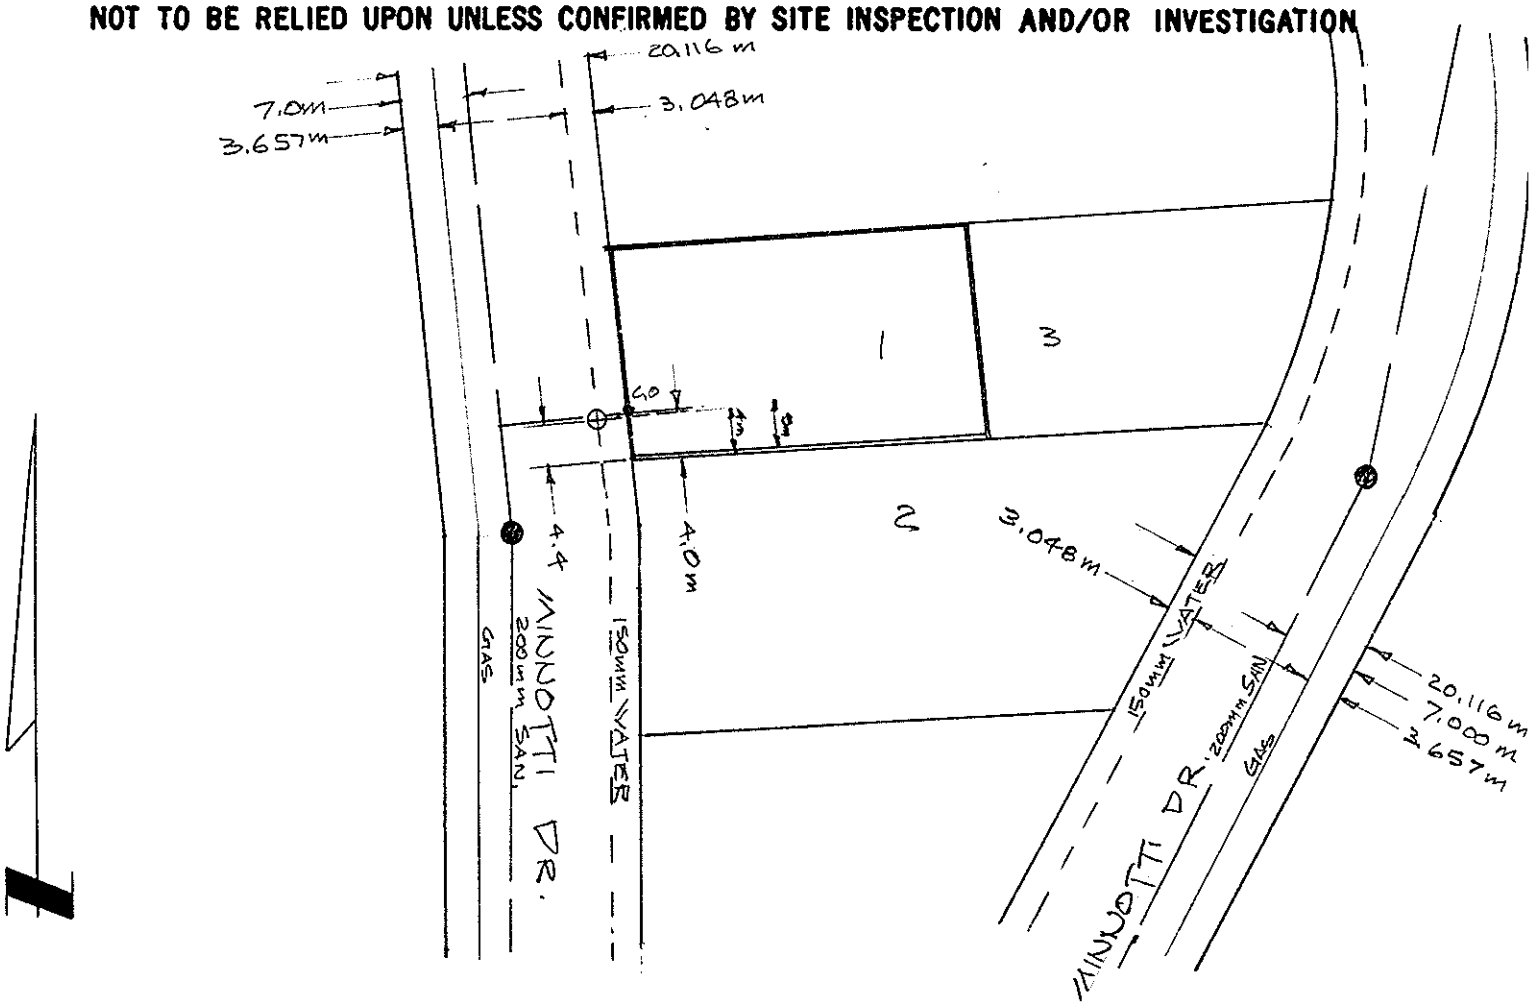
THE INFORMATION CONTAINED HEREIN IS FOR INTERNAL USE ONLY.
NOT TO BE RELIED UPON UNLESS CONFIRMED BY SITE INSPECTION AND/OR INVESTIGATION