ASSOCIATED ENGINEERING SERVICES LTD.
301 - 1777 THIRD AVENUE
PRINCE GEORGE, B.C. V2L 3G7

City of Prince George
HISTORY SHEET

SHEET NUMBER № 3170 **Roll Number** 018088.554

Legal: LOT'S 51 BLOCK D.L. 4048 PLAN 36894

Address: 4558 RAINER ~~HEIGHTS~~ CRESCENT

Sanitary Connection: # SIZE 100mm MATERIAL PVC INV. 782.15 CONNECTED

Water Connection # SIZE 19mm MATERIAL COPPER METER CONNECTED

Storm Connection: # SIZE MATERIAL INV. CONNECTED

Cash Receipt No's: WATER SANITARY STORM

CURB FROM PROPERTY LINE ROLL CURB 5.0 M PAVEMENT WIDTH 10.0 M

B.C. HYDRO UNDERGROUND CONNECTION

B.C. TELEPHONE UNDERGROUND CONNECTION

INLAND GAS

Information Sheets:

THE INFORMATION CONTAINED HEREIN IS FOR INTERNAL USE ONLY. NOT TO BE RELIED UPON UNLESS CONFIRMED BY SITE INSPECTION AND/OR INVESTIGATION.

Comments: CITY BM #1969-79 ELEV. 777.168 HY. SP. SW. CORNER HIGHLAND & MONTGOMERY. WEST LEG.
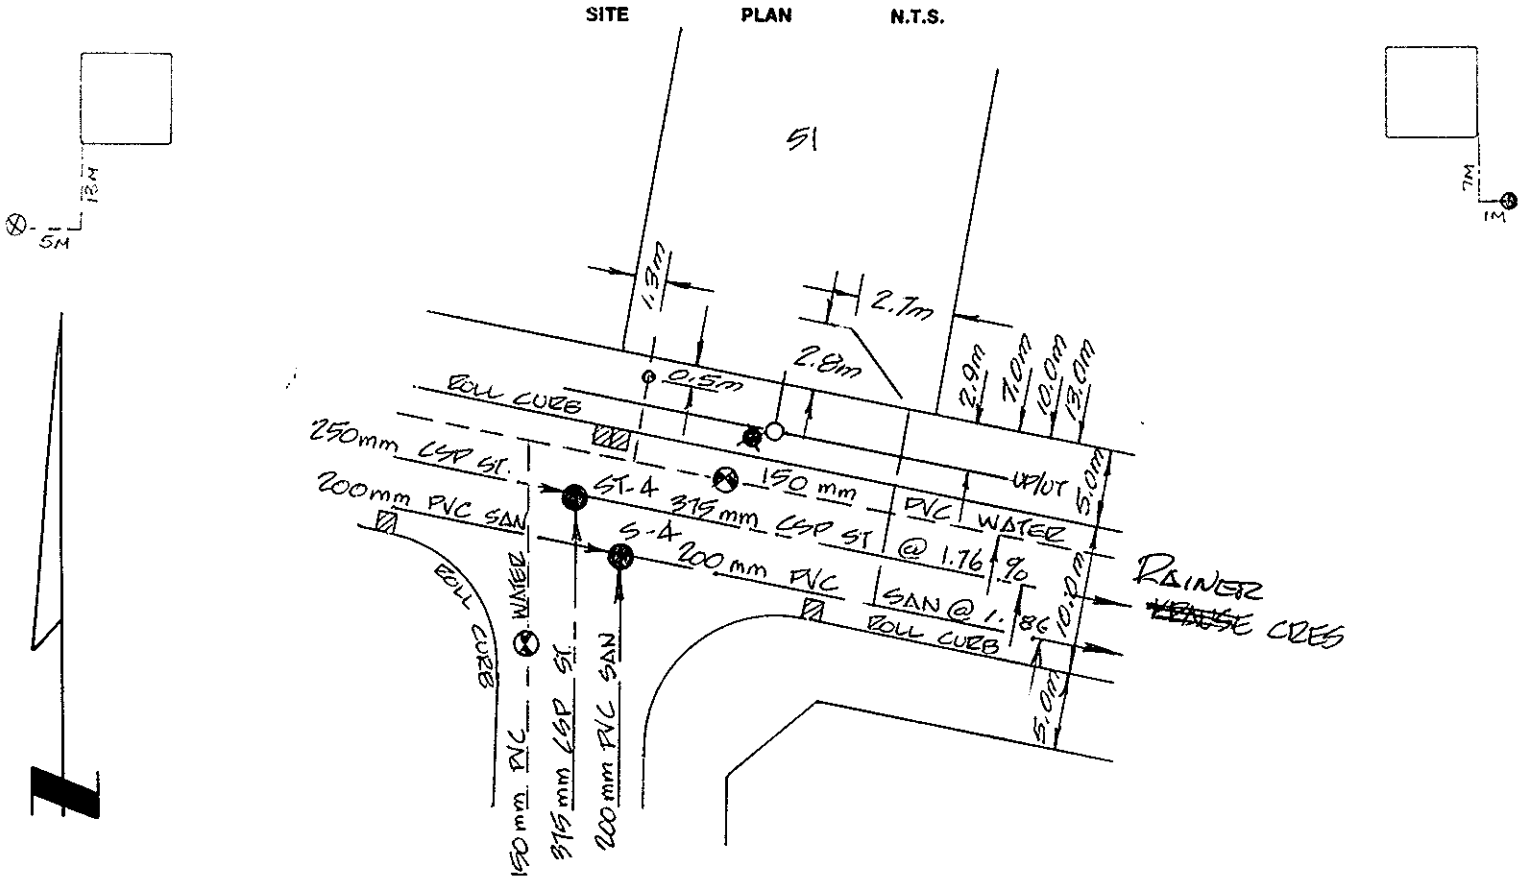
SITE PLAN N.T.S.