City of Prince George
HISTORY SHEET

SHEET NUMBER **Roll Number** 018187323

Legal: LOT'S 2 BLOCK D.L. 954 PLAN 37050

Address: 273 BLACKBURN RD

Sanitary Connection: # SIZE 100MM MATERIAL PVC INV. CONNECTED

Water Connection # SIZE 20MM MATERIAL Copper METER CONNECTED

Storm Connection: # SIZE MATERIAL INV. CONNECTED

Cash Receipt No's: WATER 11213 SANITARY 11213 STORM

CURB FROM PROPERTY LINE PAVEMENT WIDTH

B.C. HYDRO UNDERGROUND CONNECTION

B.C. TELEPHONE UNDERGROUND CONNECTION

INLAND GAS

Information Sheets:

Comments:
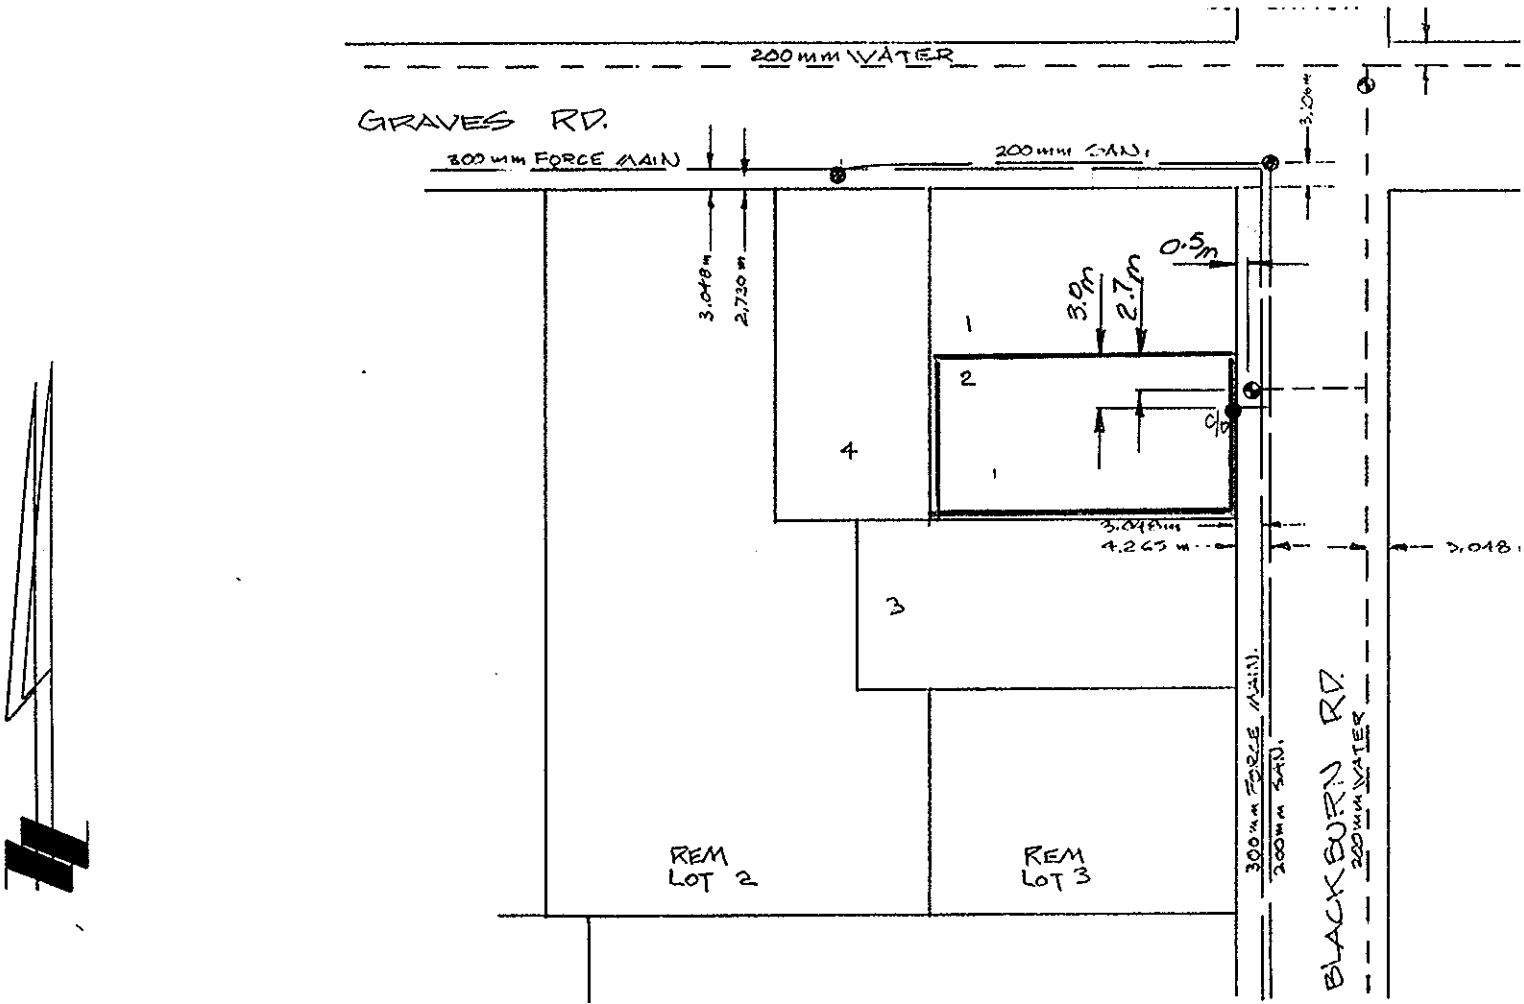
THE INFORMATION CONTAINED HEREIN IS FOR INTERNAL USE ONLY.
NOT TO BE RELIED UPON UNLESS CONFIRMED BY SITE INSPECTION AND/OR INVESTIGATION