# City of Prince George
## HISTORY SHEET

SHEET NUMBER **Roll Number** 0185/1830

**Legal:** LOT'S 11 BLOCK Rem of S.W. 1/4 D.L. 1599 PLAN 37628

**Address:** 5511 Heyer Road

**Sanitary Connection:** # SIZE 100 MATERIAL PVC INV. 728.710 CONNECTED

**Water Connection** # SIZE 20 MATERIAL Cu METER CONNECTED

**Storm Connection:** # SIZE 100 MATERIAL PVC INV. 728.680 CONNECTED

**Cash Receipt No's:** WATER SANITARY STORM

CURB FROM PROPERTY LINE 5.0m PAVEMENT WIDTH 10.0m

B.C. HYDRO U.G. UNDERGROUND CONNECTION

B.C. TELEPHONE U.G. UNDERGROUND CONNECTION

INLAND GAS 60 mm on HEYER RD, 1.5m from P.L.

**Information Sheets:**

**Comments:**

THE INFORMATION CONTAINED HEREIN IS FOR INTERNAL USE ONLY. NOT TO BE RELIED UPON UNLESS CONFIRMED BY SITE INSPECTION AND/OR INVESTIGATION.
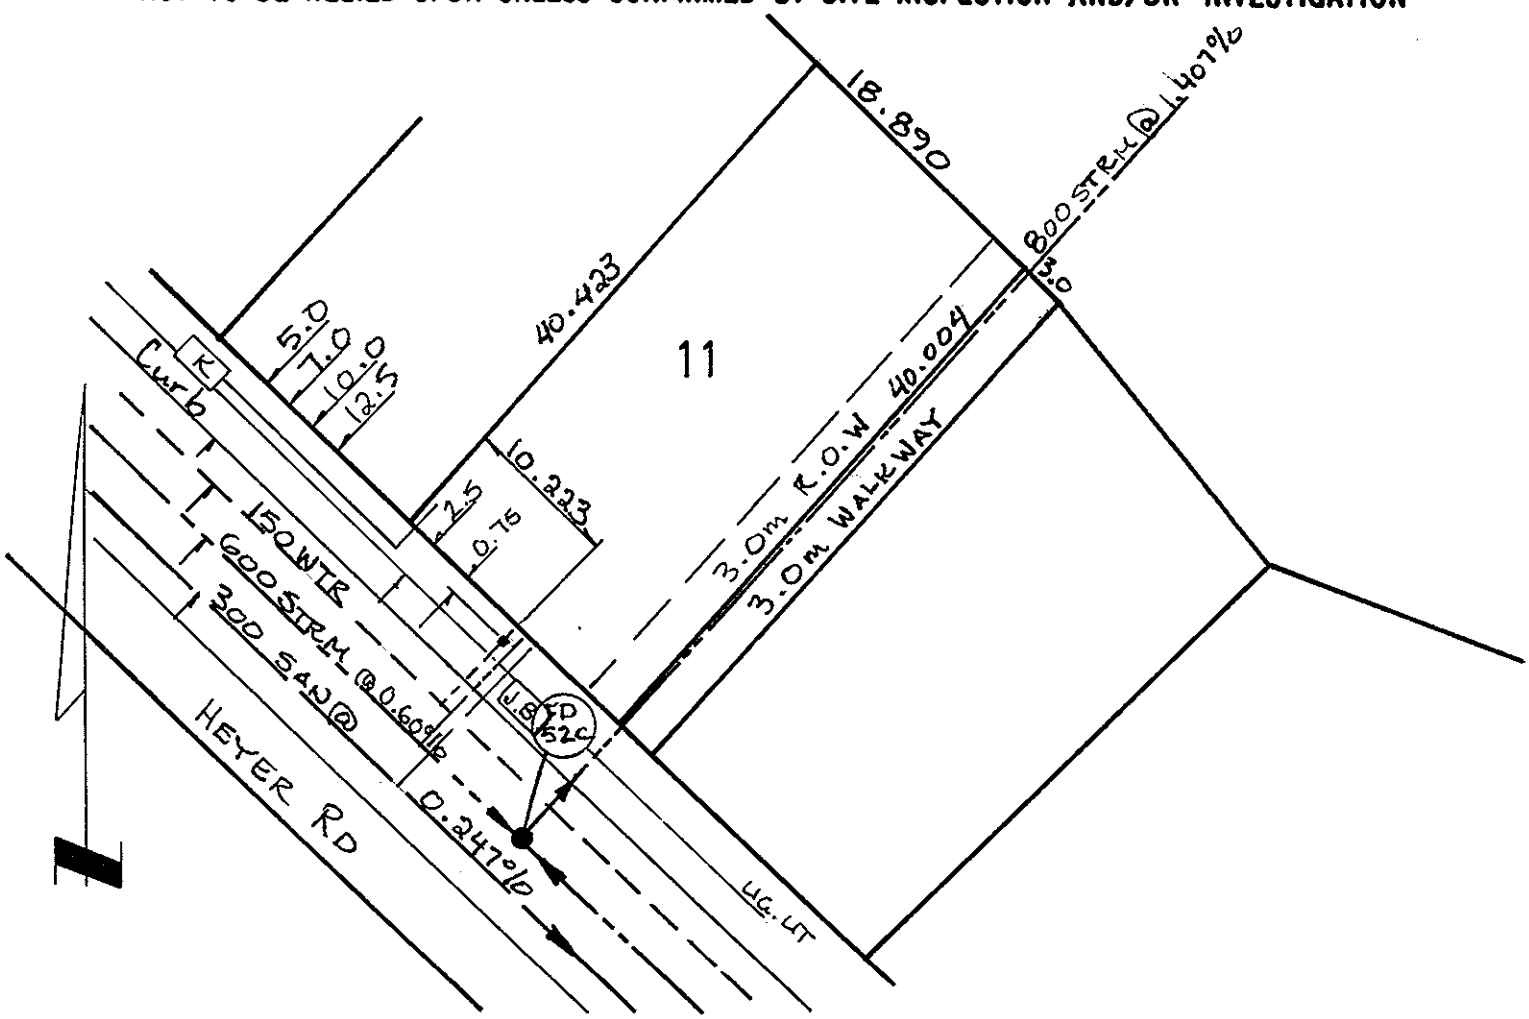
**THE INFORMATION CONTAINED HEREIN IS FOR INTERNAL USE ONLY.**
**NOT TO BE RELIED UPON UNLESS CONFIRMED BY SITE INSPECTION AND/OR INVESTIGATION**